



**1** EXISTING MAIN LEVEL FLOOR PLAN  
 13,588 SQFT INTERIOR  
 2,149 SQFT EXTERIOR  
 SCALE : 1/8"=1'-0"

EXISTING FLOOR PLAN  
 CHURCH, FREMONT CA.

A2.2

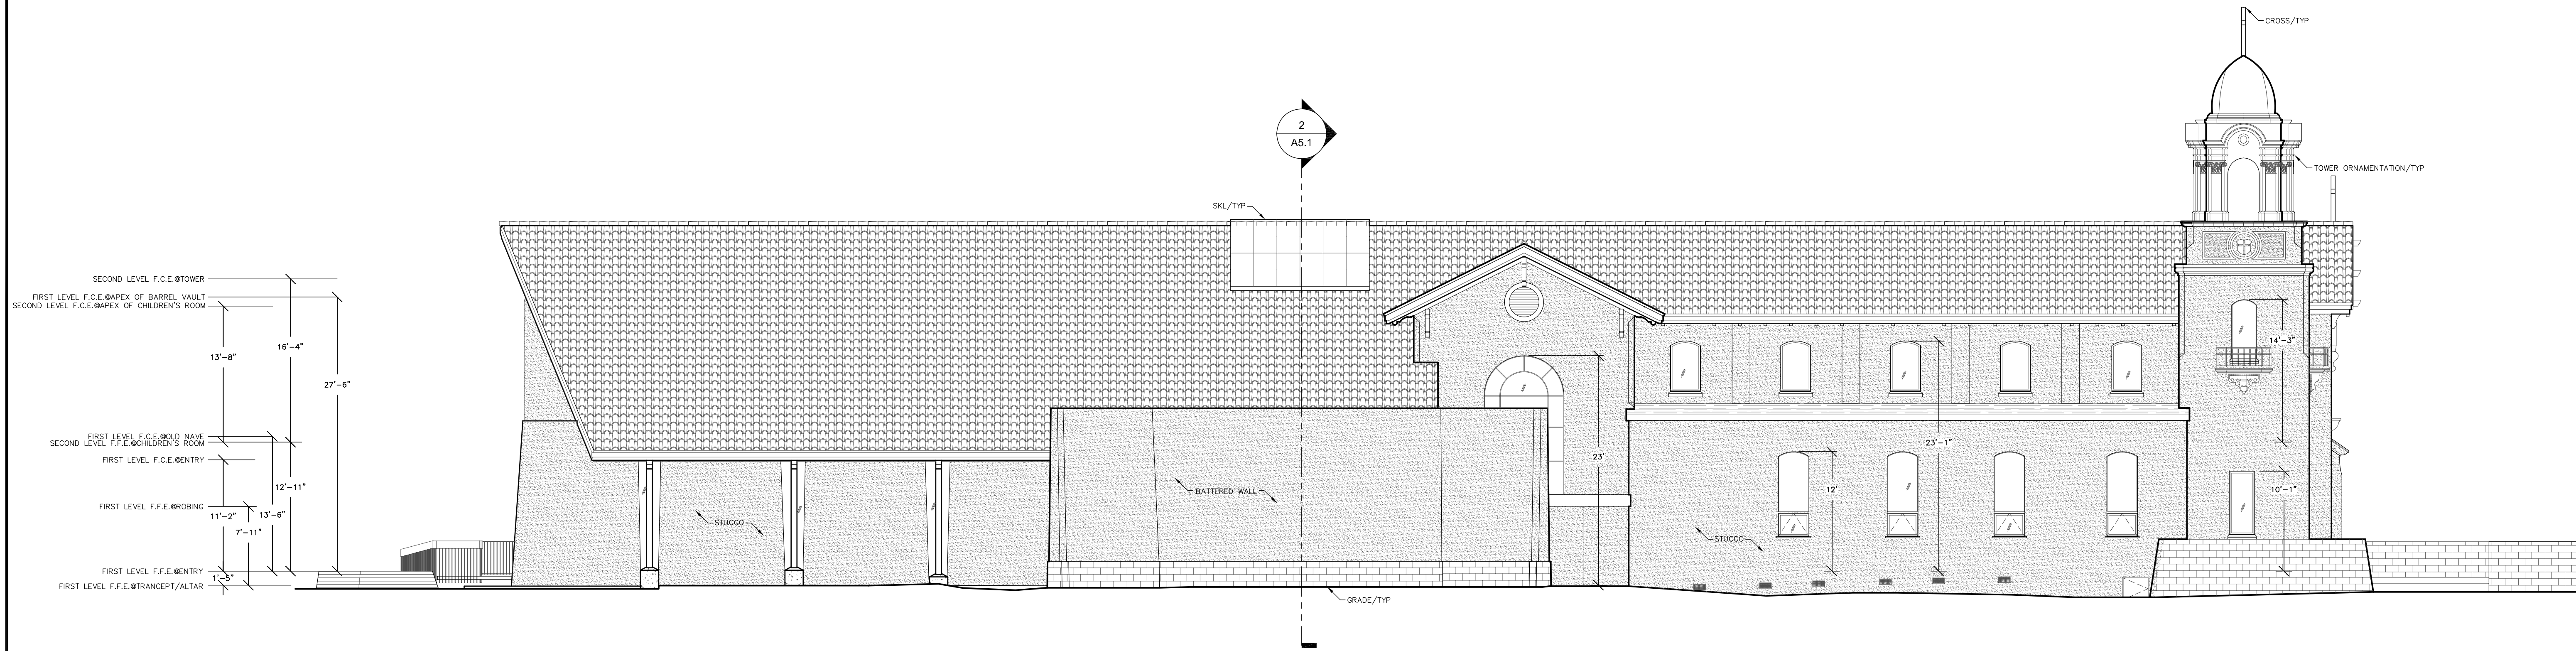


2 EXISTING WEST ELEVATION  
SCALE : 1/8"=1'-0"

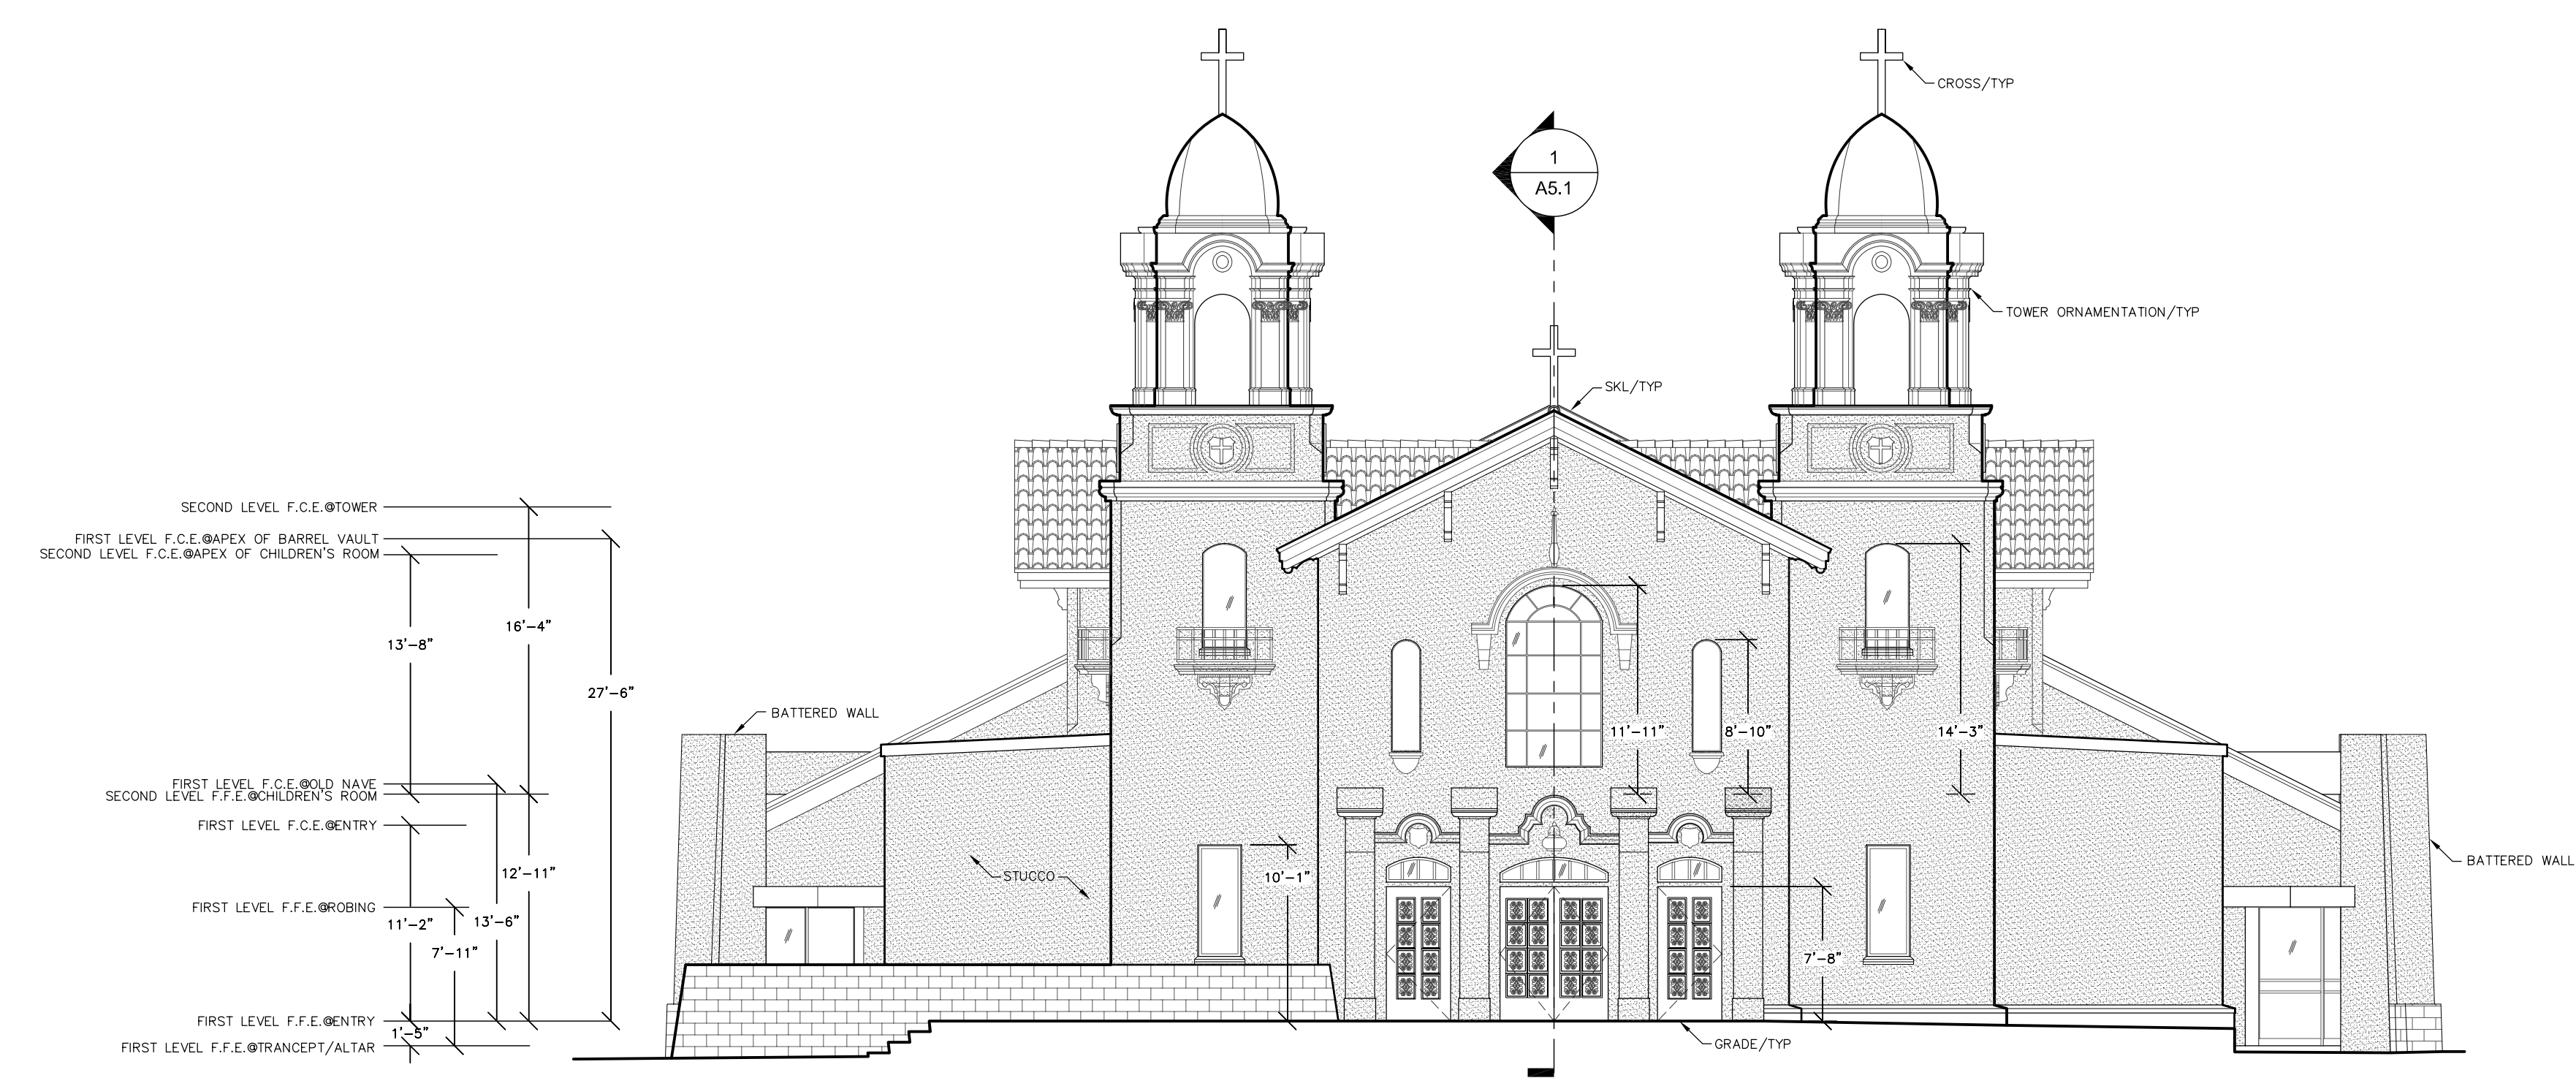

1 EXISTING SOUTH ELEVATION  
SCALE : 1/8"=1'-0"


EXISTING EXTERIOR ELEVATIONS  
CHURCH, FREMONT CA.

A3.1

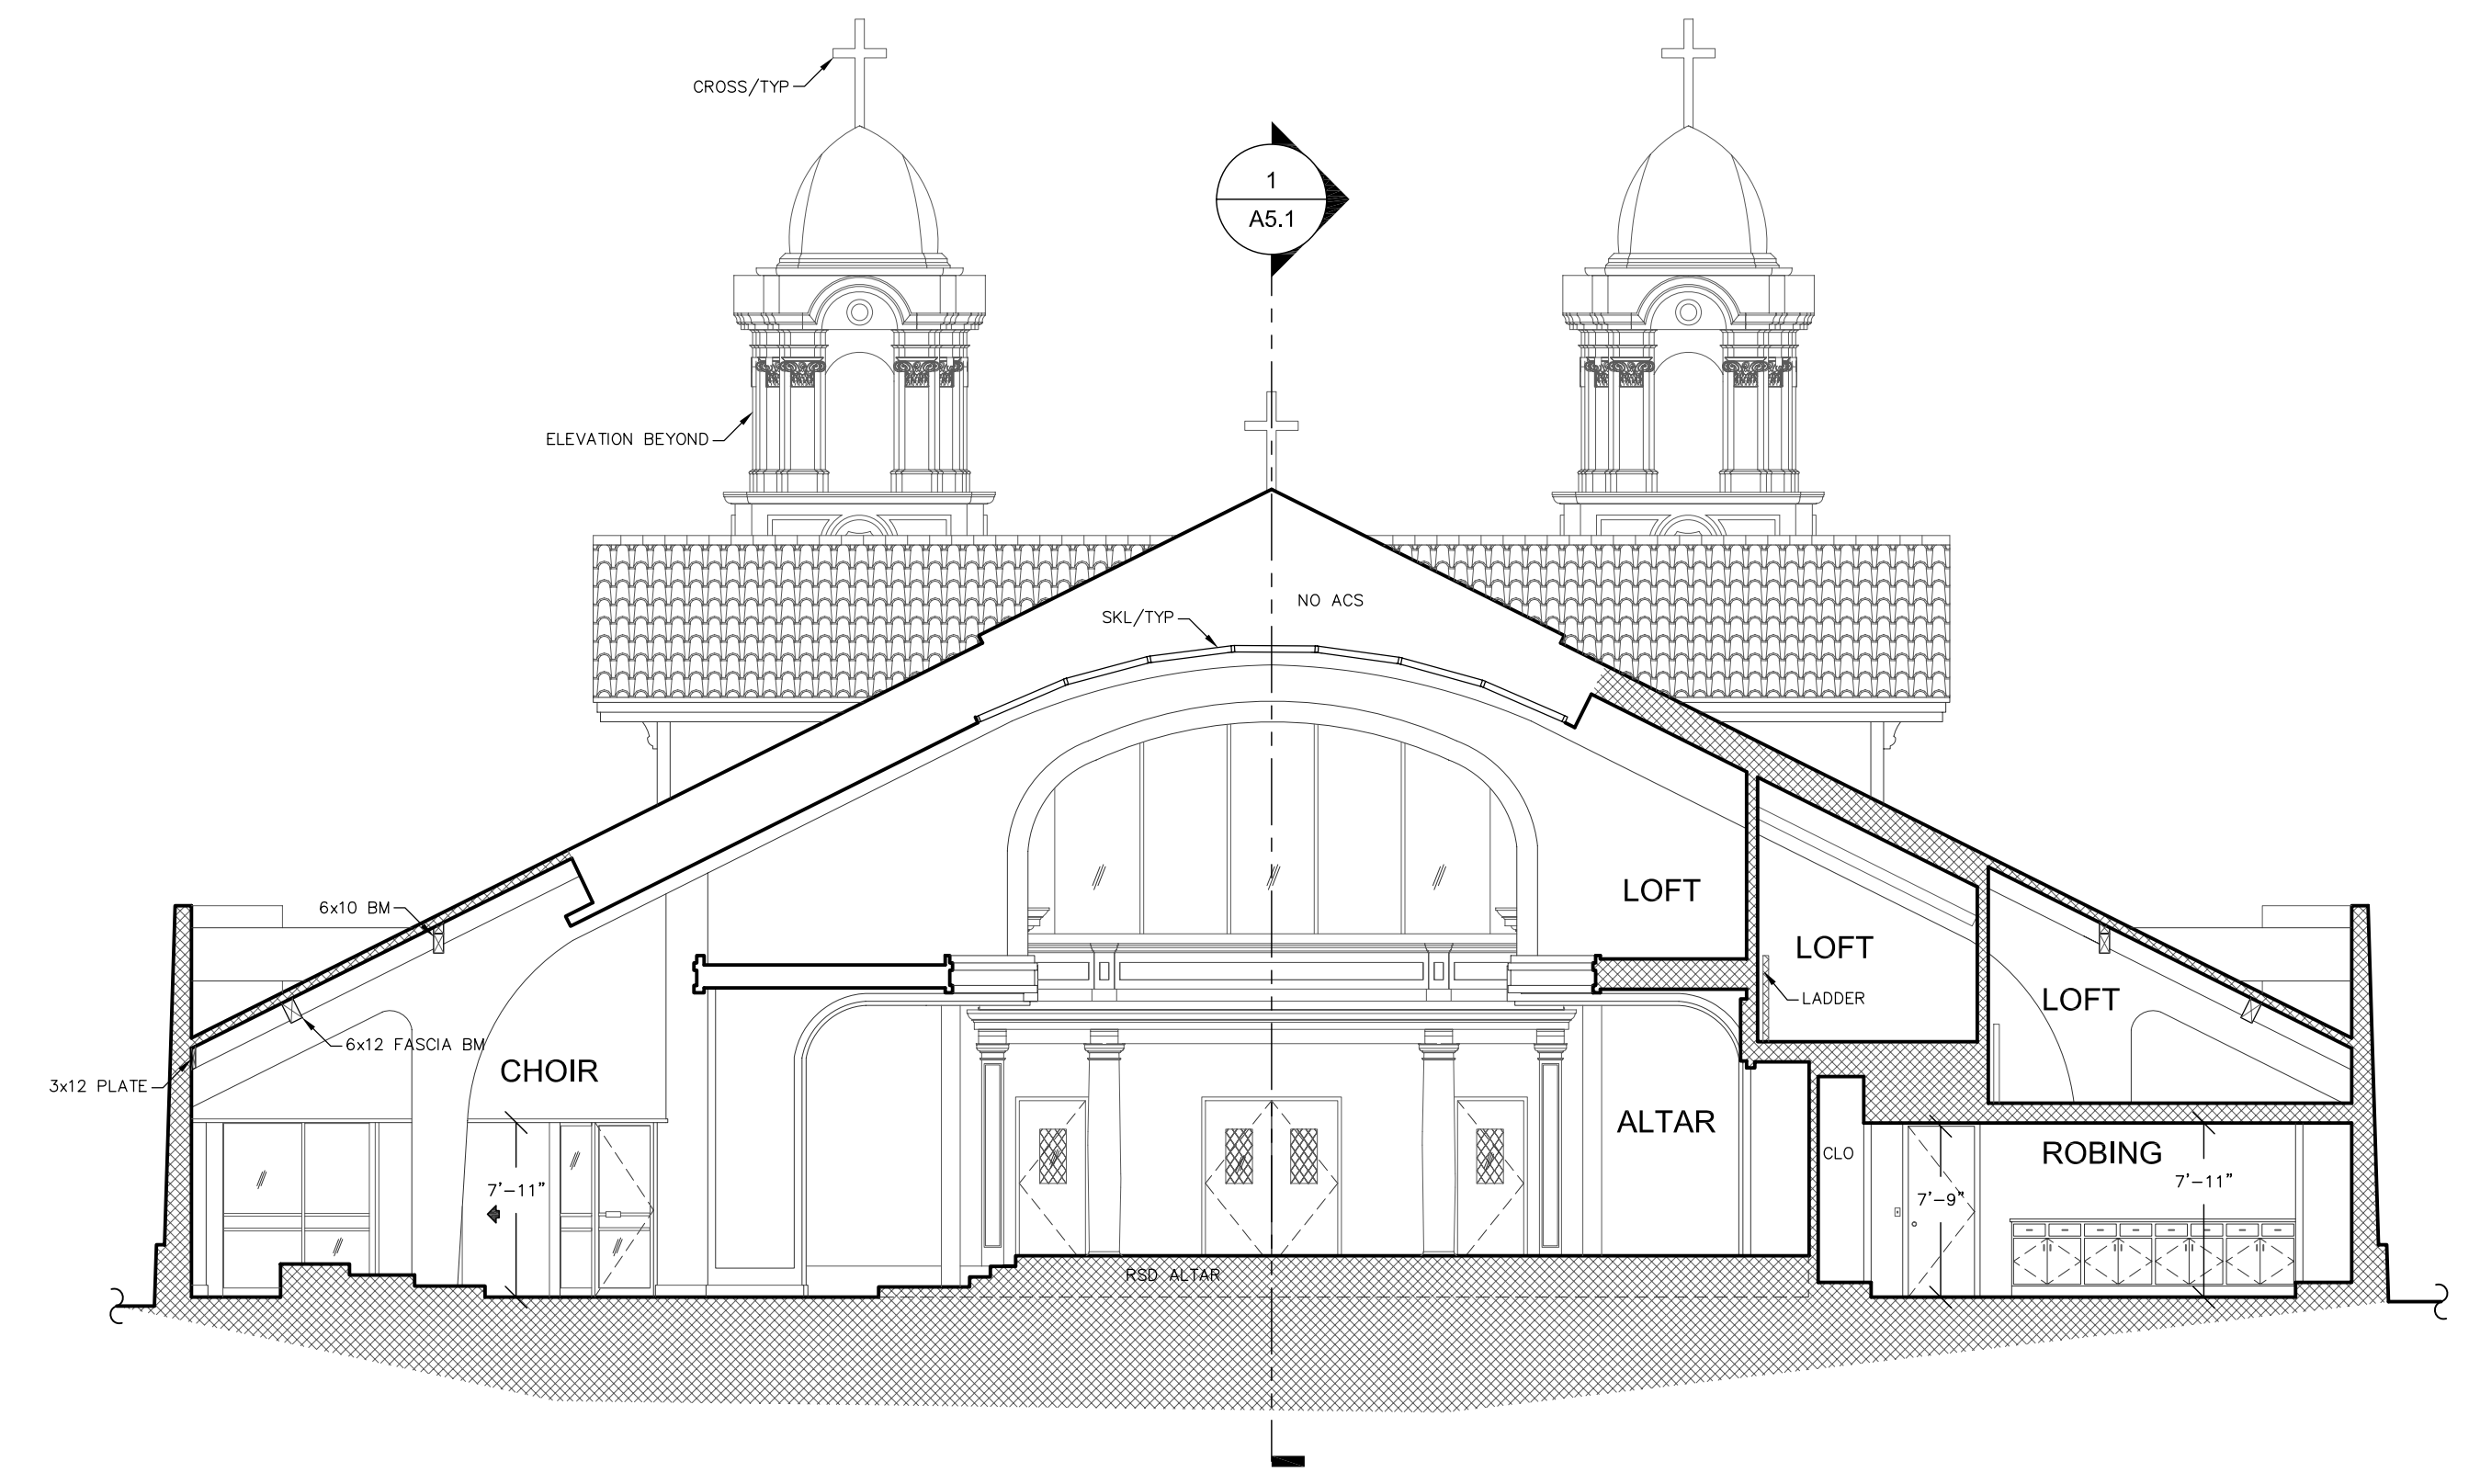

2 EXISTING CROSS SECTION  
 SCALE: 1/8"=1'-0"

DATUM

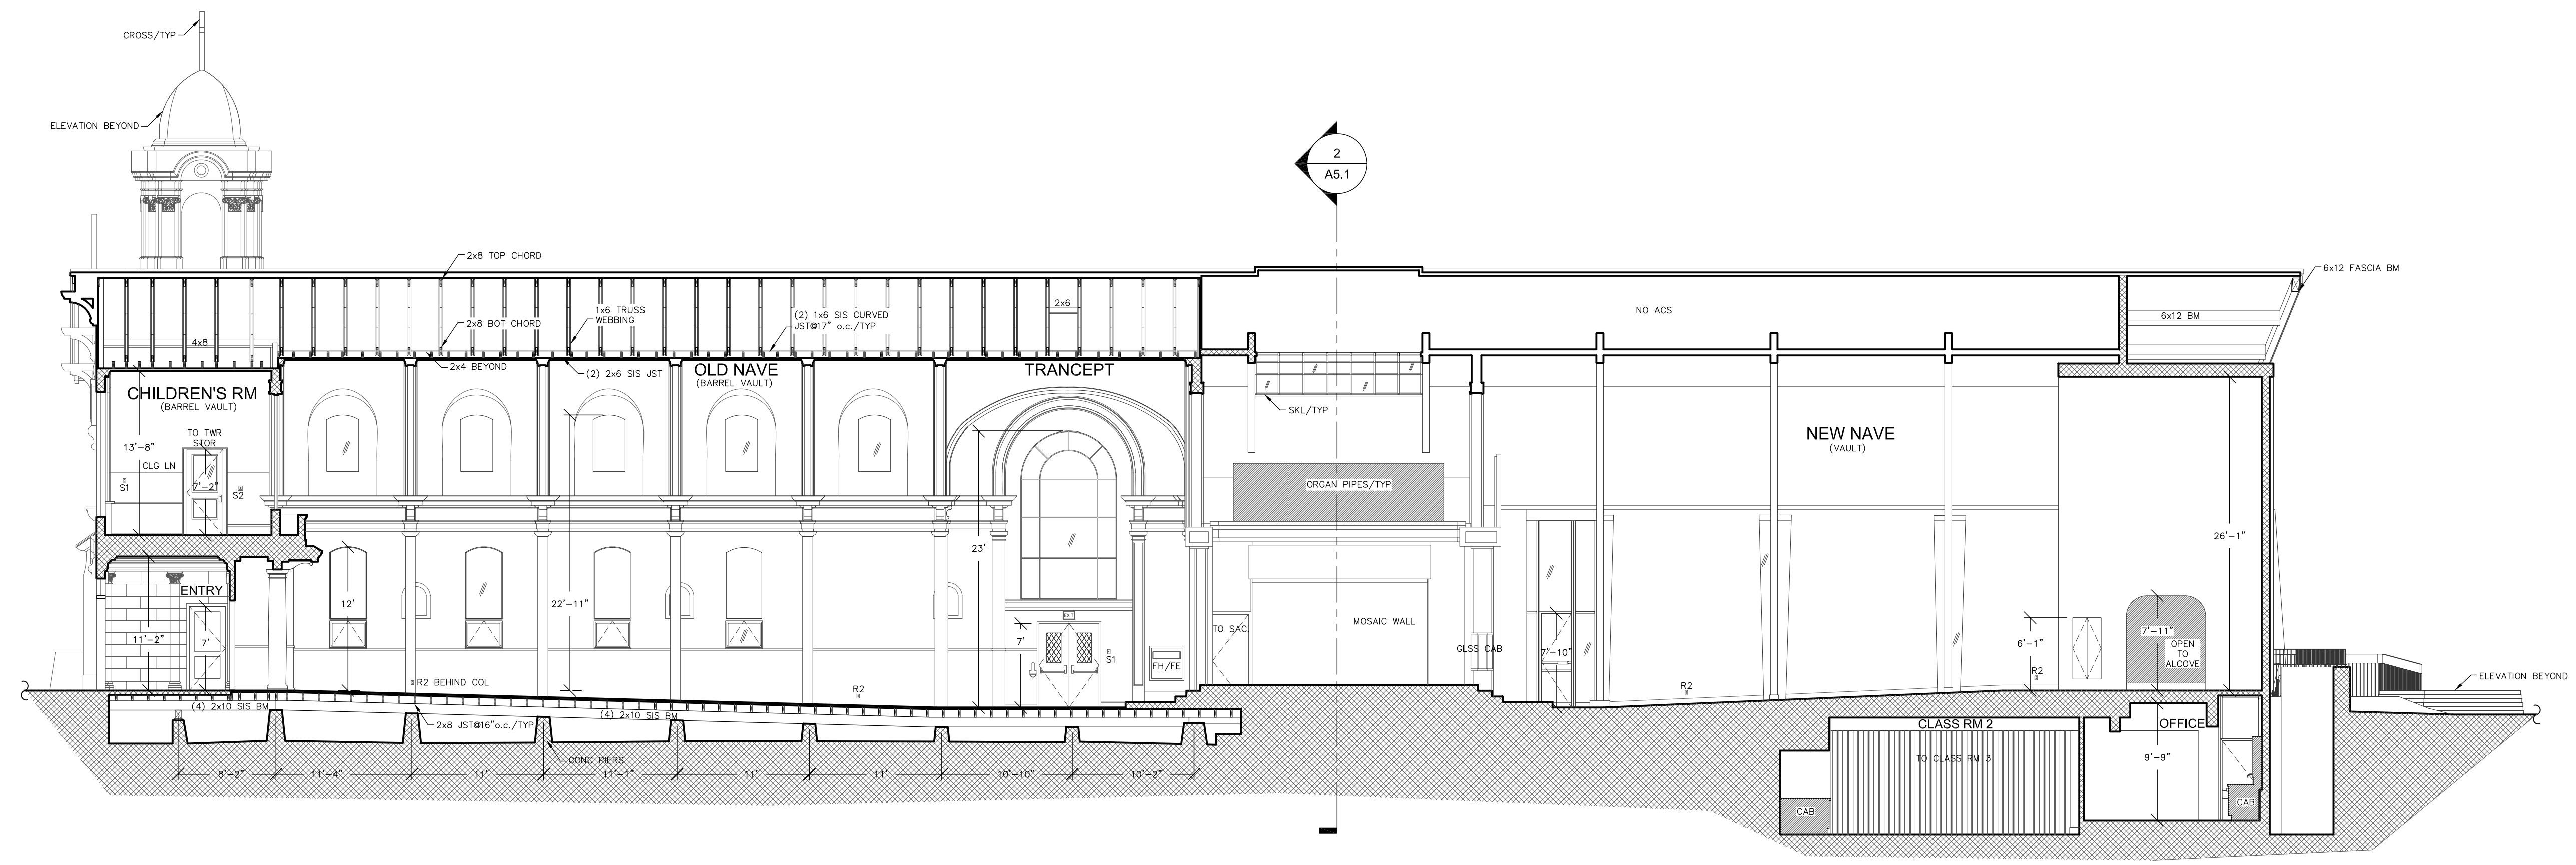


1 EXISTING LONGITUDINAL SECTION  
 SCALE: 1/8"=1'-0"

DATUM

EXISTING SECTIONS  
 CHURCH, FREMONT CA.

A5.1

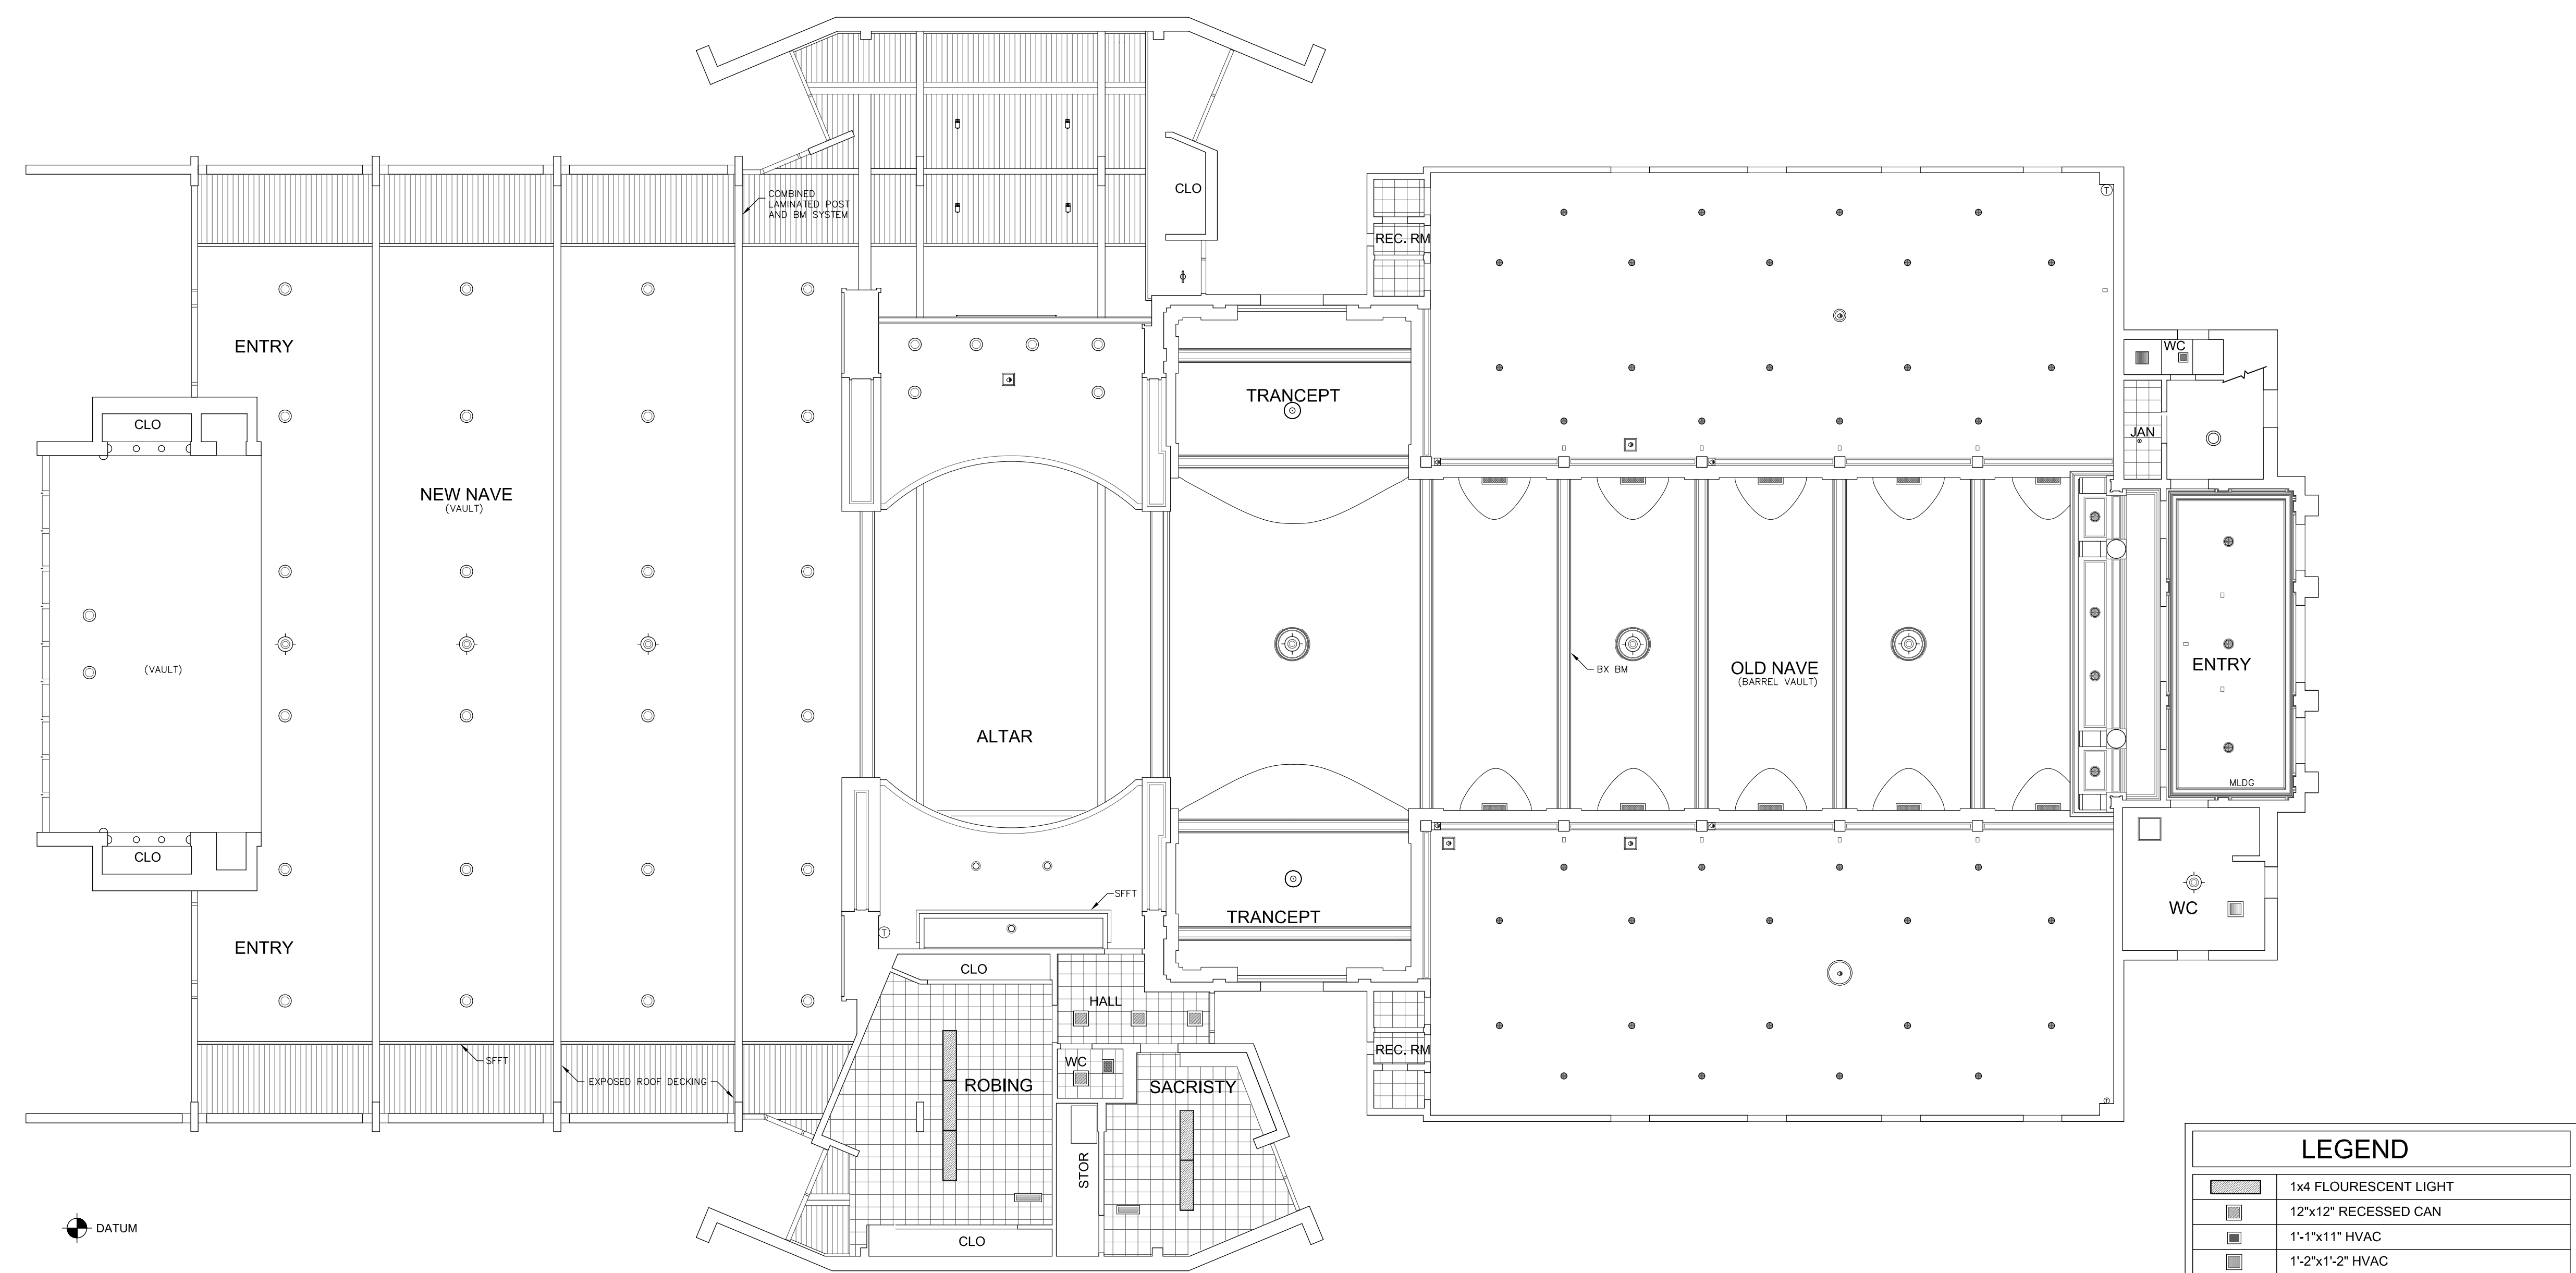

LEGEND	
[Symbol]	1x4 FLOURESCENT LIGHT
[Symbol]	12"x12" RECESSED CAN
[Symbol]	1'-1"x11" HVAC
[Symbol]	1'-2"x1'-2" HVAC
[Symbol]	1'-10"x8" HVAC
[Symbol]	12" RECESSED CAN
[Symbol]	14" HANGING LIGHT
[Symbol]	6" RECESSED CAN
[Symbol]	6" RECESSED CAN
[Symbol]	FACE PLATE
[Symbol]	SPOT LIGHT
[Symbol]	EXIT SIGN
[Symbol]	SPEAKER
[Symbol]	SPEAKER

**1** EXISTING MAIN LEVEL REFLECTED CEILING PLAN  
 13,588 SQFT INTERIOR  
 2,149 SQFT EXTERIOR  
 SCALE : 1/8"=1'-0"

EXISTING REFLECTED CEILING PLAN  
 CHURCH, FREMONT CA.