



2 EXISTING ENTRY LEVEL FLOOR PLAN  
 1,325 SQFT INTERIOR  
 447 SQFT EXTERIOR  
 SCALE : 1/4"=1'-0"

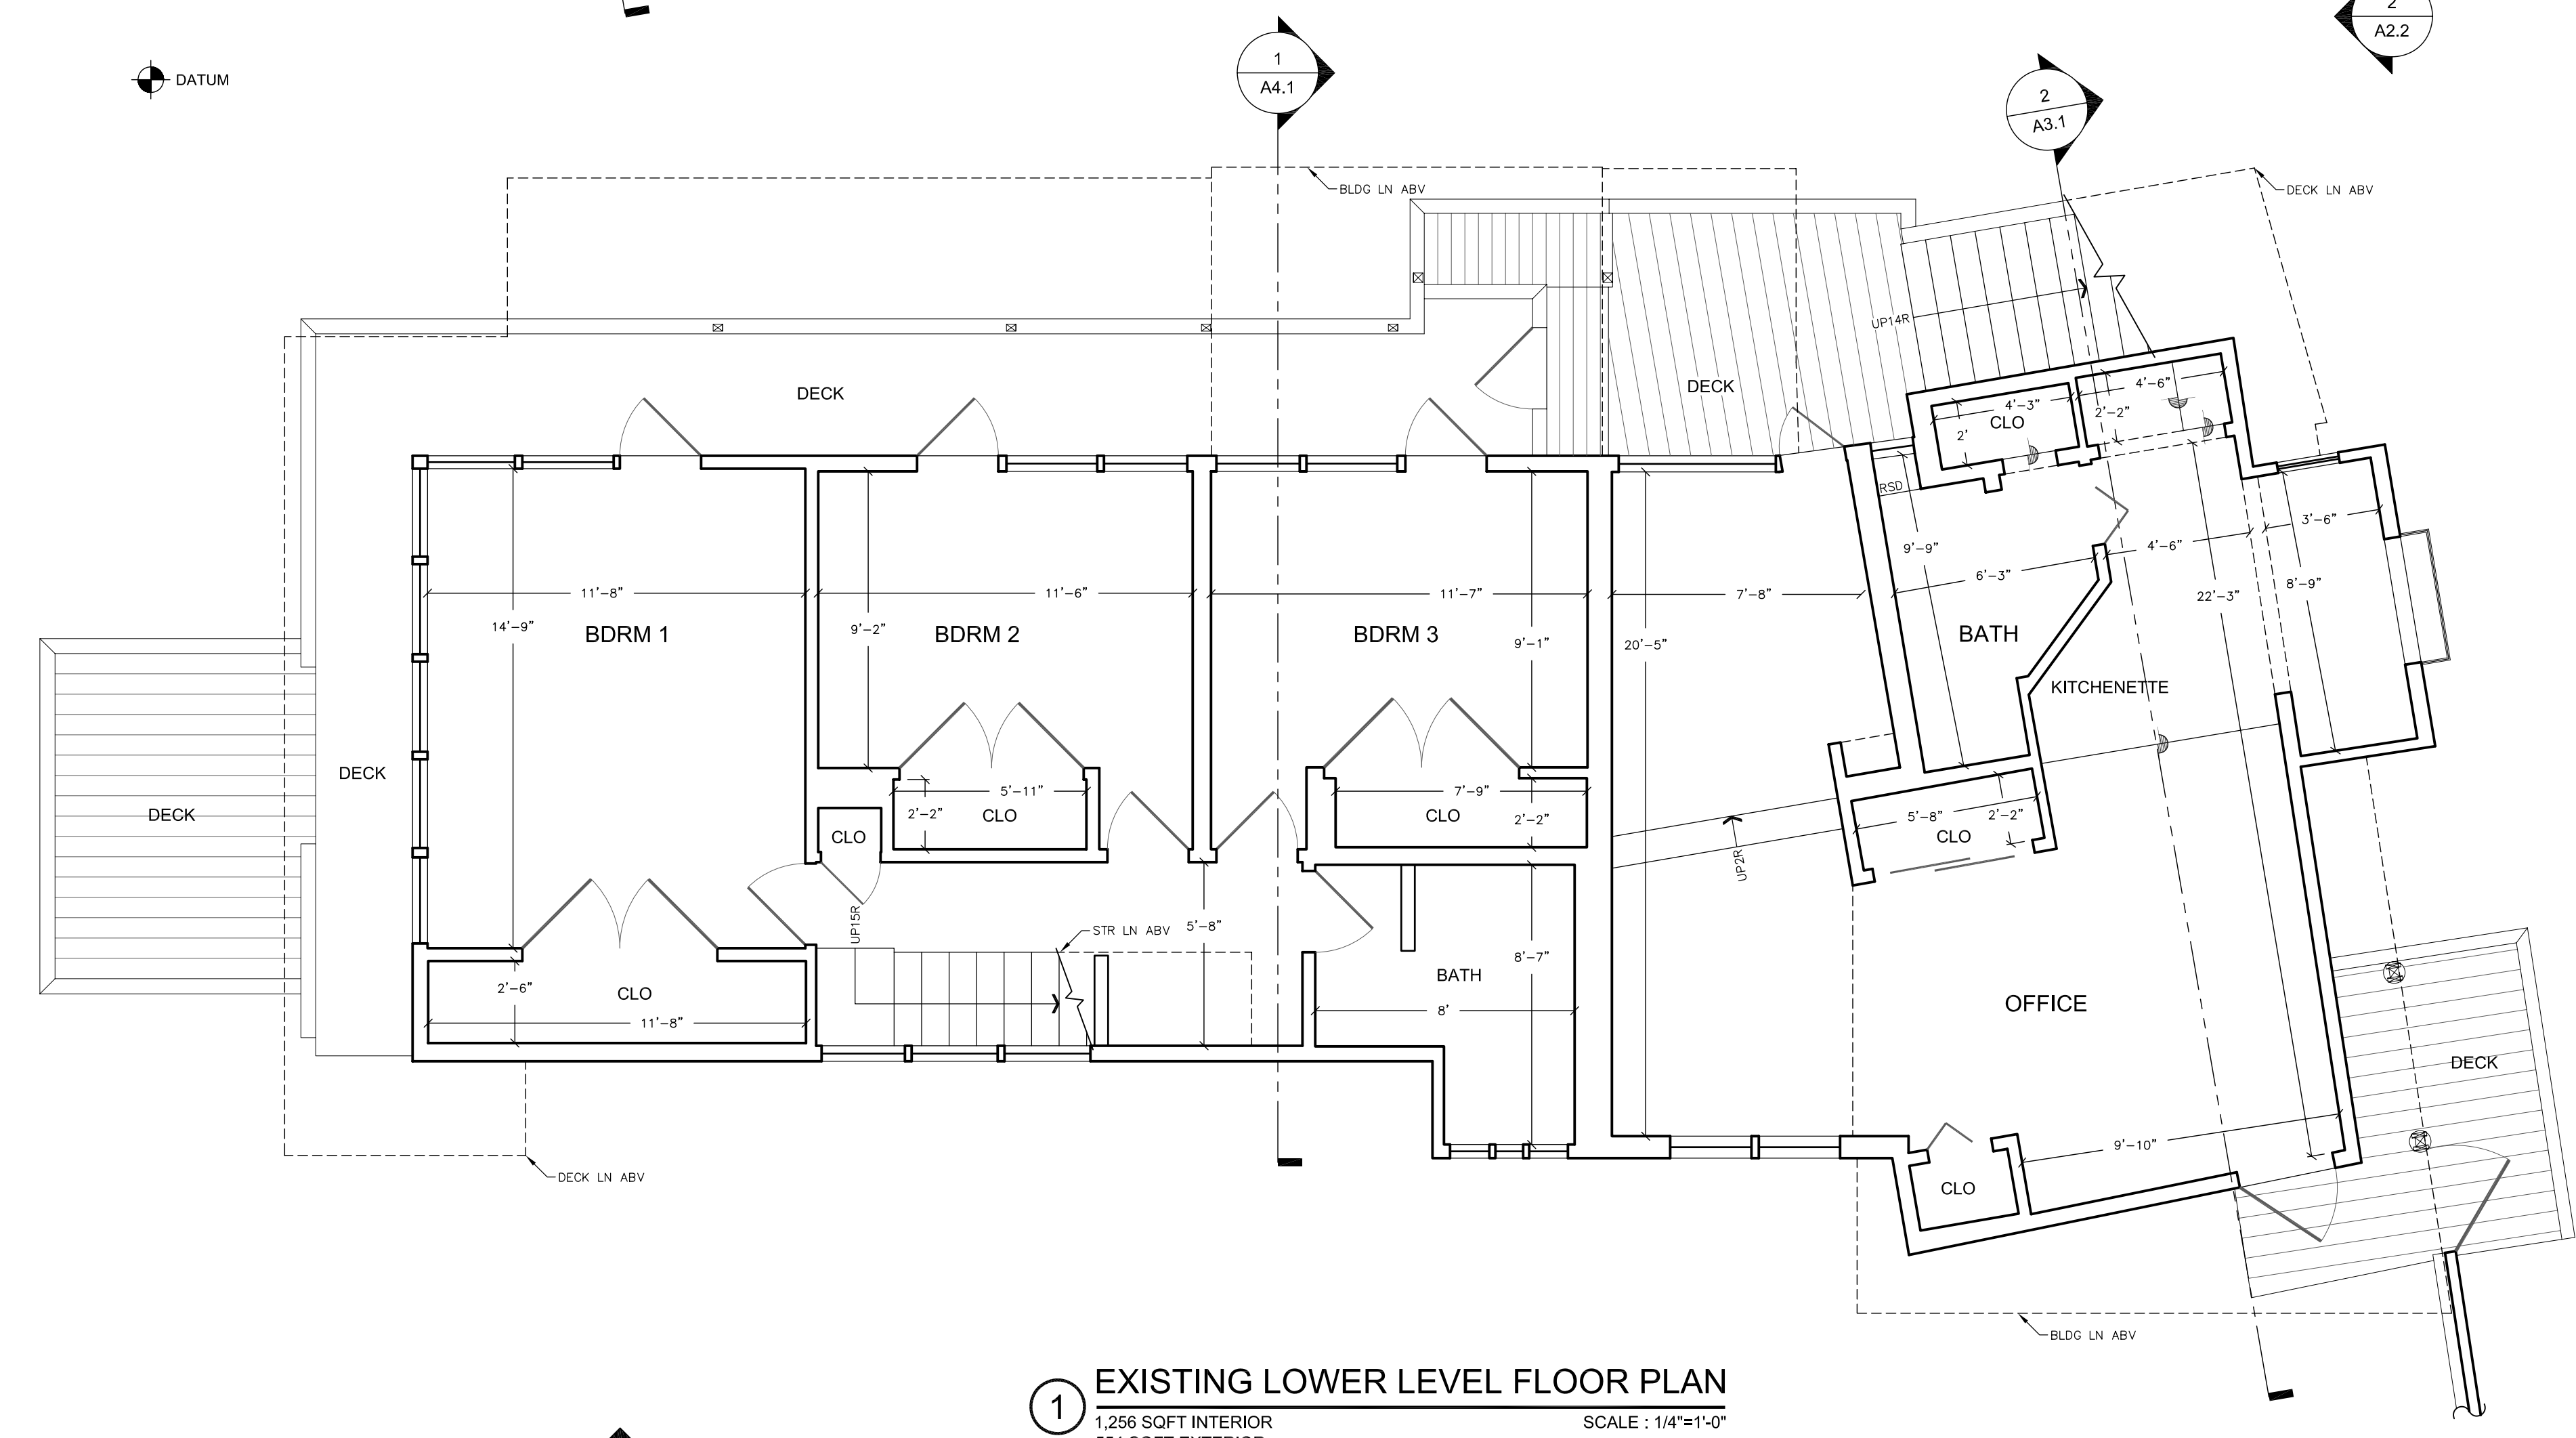


1 EXISTING LOWER LEVEL FLOOR PLAN  
 1,256 SQFT INTERIOR  
 554 SQFT EXTERIOR  
 SCALE : 1/4"=1'-0"

EXISTING FLOOR PLANS  
 FOG CITY AS-BUILTS - PROVIDER OF ACCURATE AS BUILT CONDITIONS

A1.1

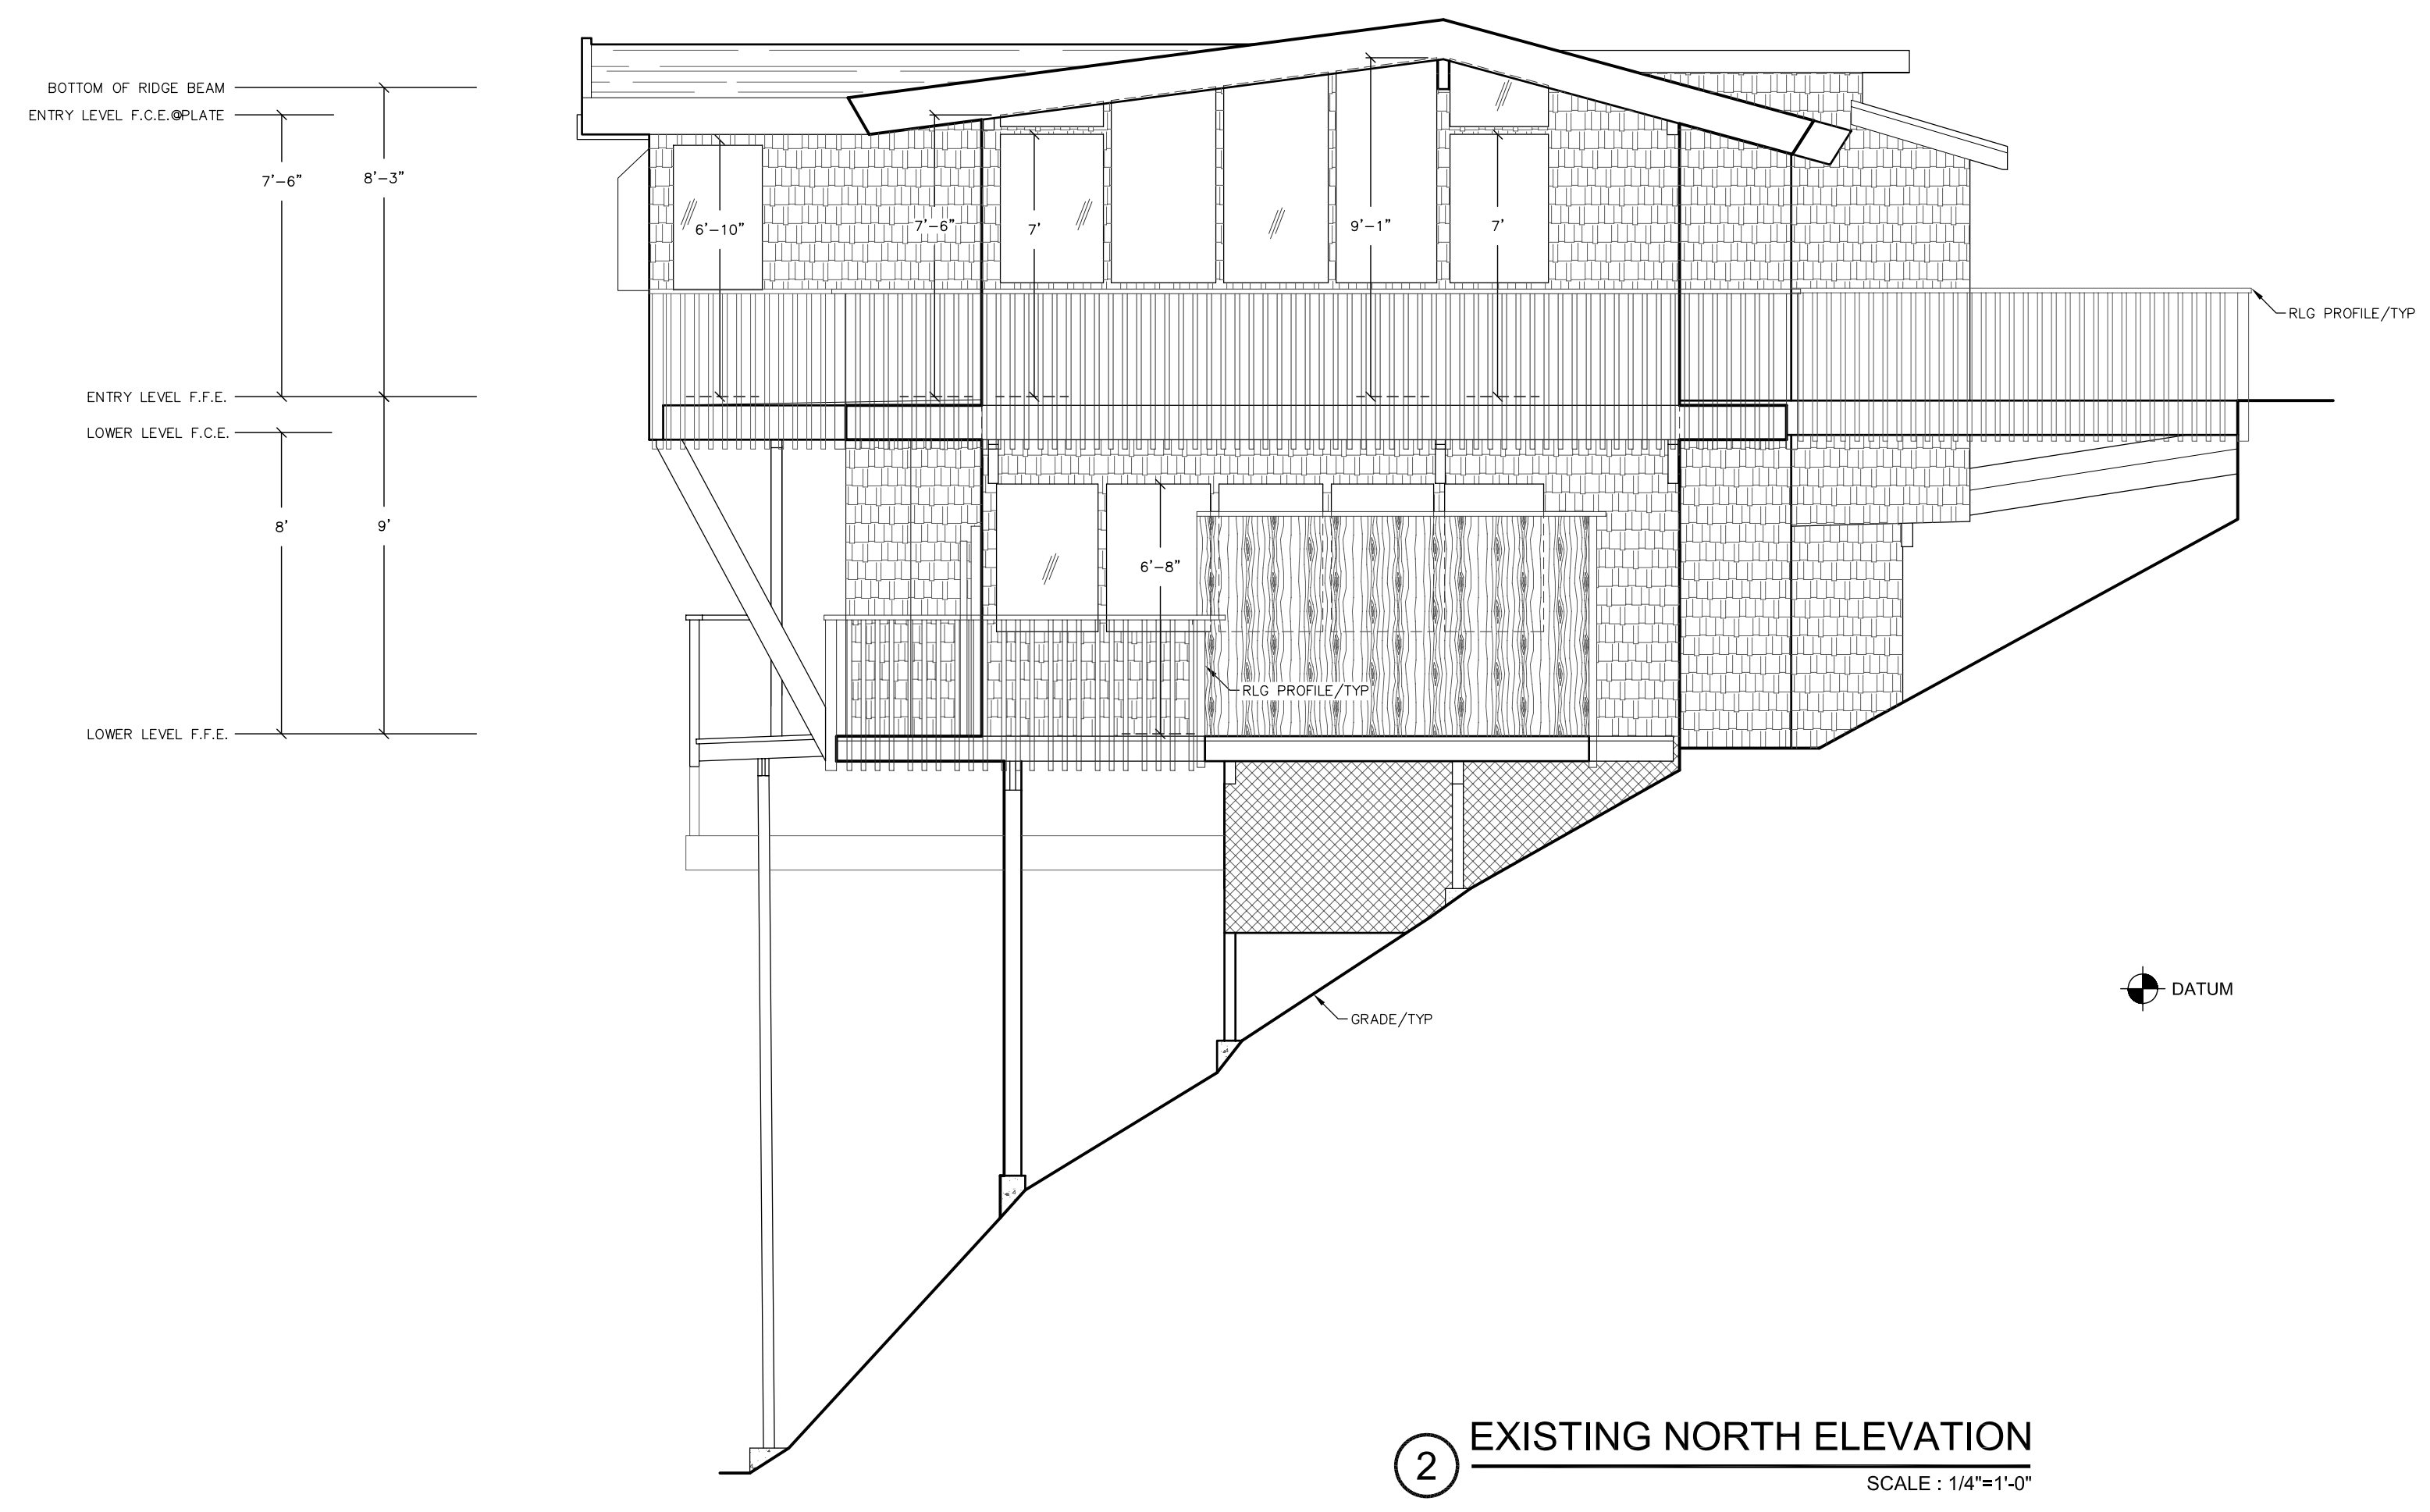

② EXISTING NORTH ELEVATION  
 SCALE : 1/4"=1'-0"

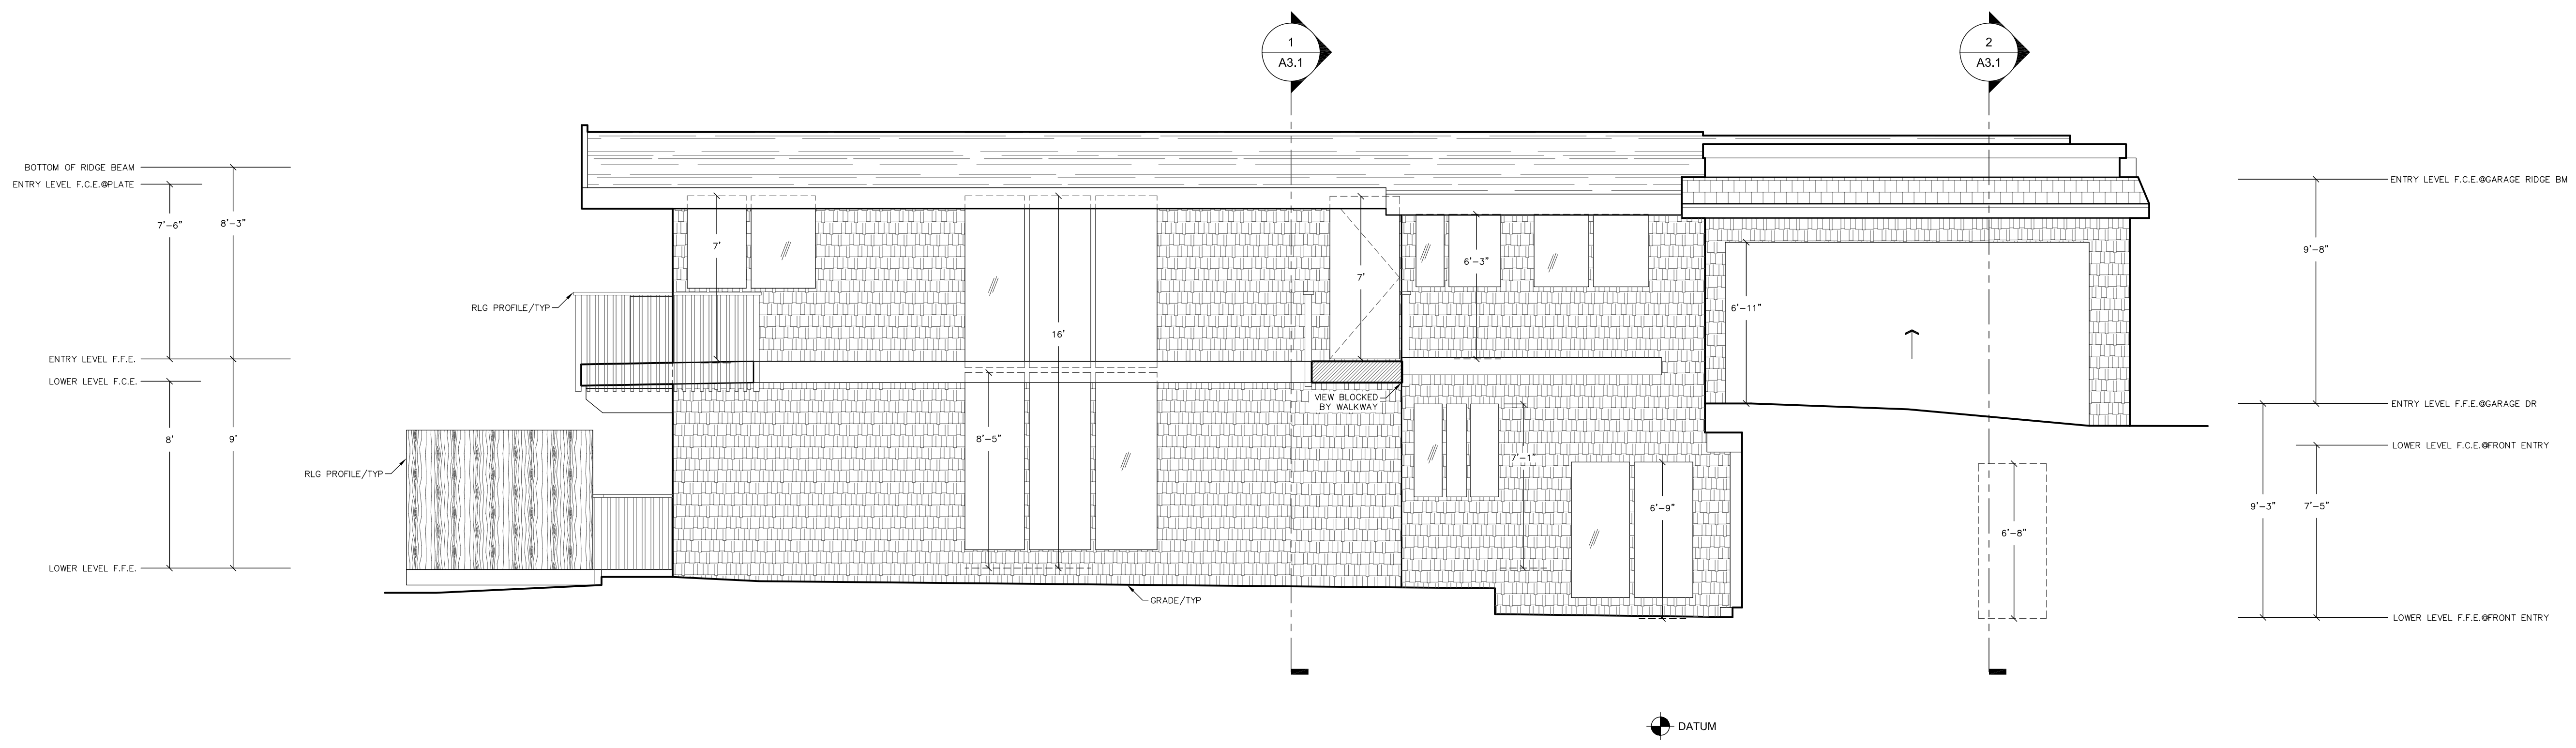


① EXISTING WEST ELEVATION  
 SCALE : 1/4"=1'-0"


EXISTING ELEVATIONS  
 FOG CITY AS-BUILTS - PROVIDER OF ACCURATE AS BUILT CONDITIONS

AS BUILT DOCUMENTATION OF EXISTING  
 CONDITIONS OF REAL ESTATE PROPERTY

THESE ARE BASIC ELEVATIONS.  
 SINGLE LINE REPRESENTATION OF  
 MAJOR STRUCTURAL ELEMENTS ONLY.

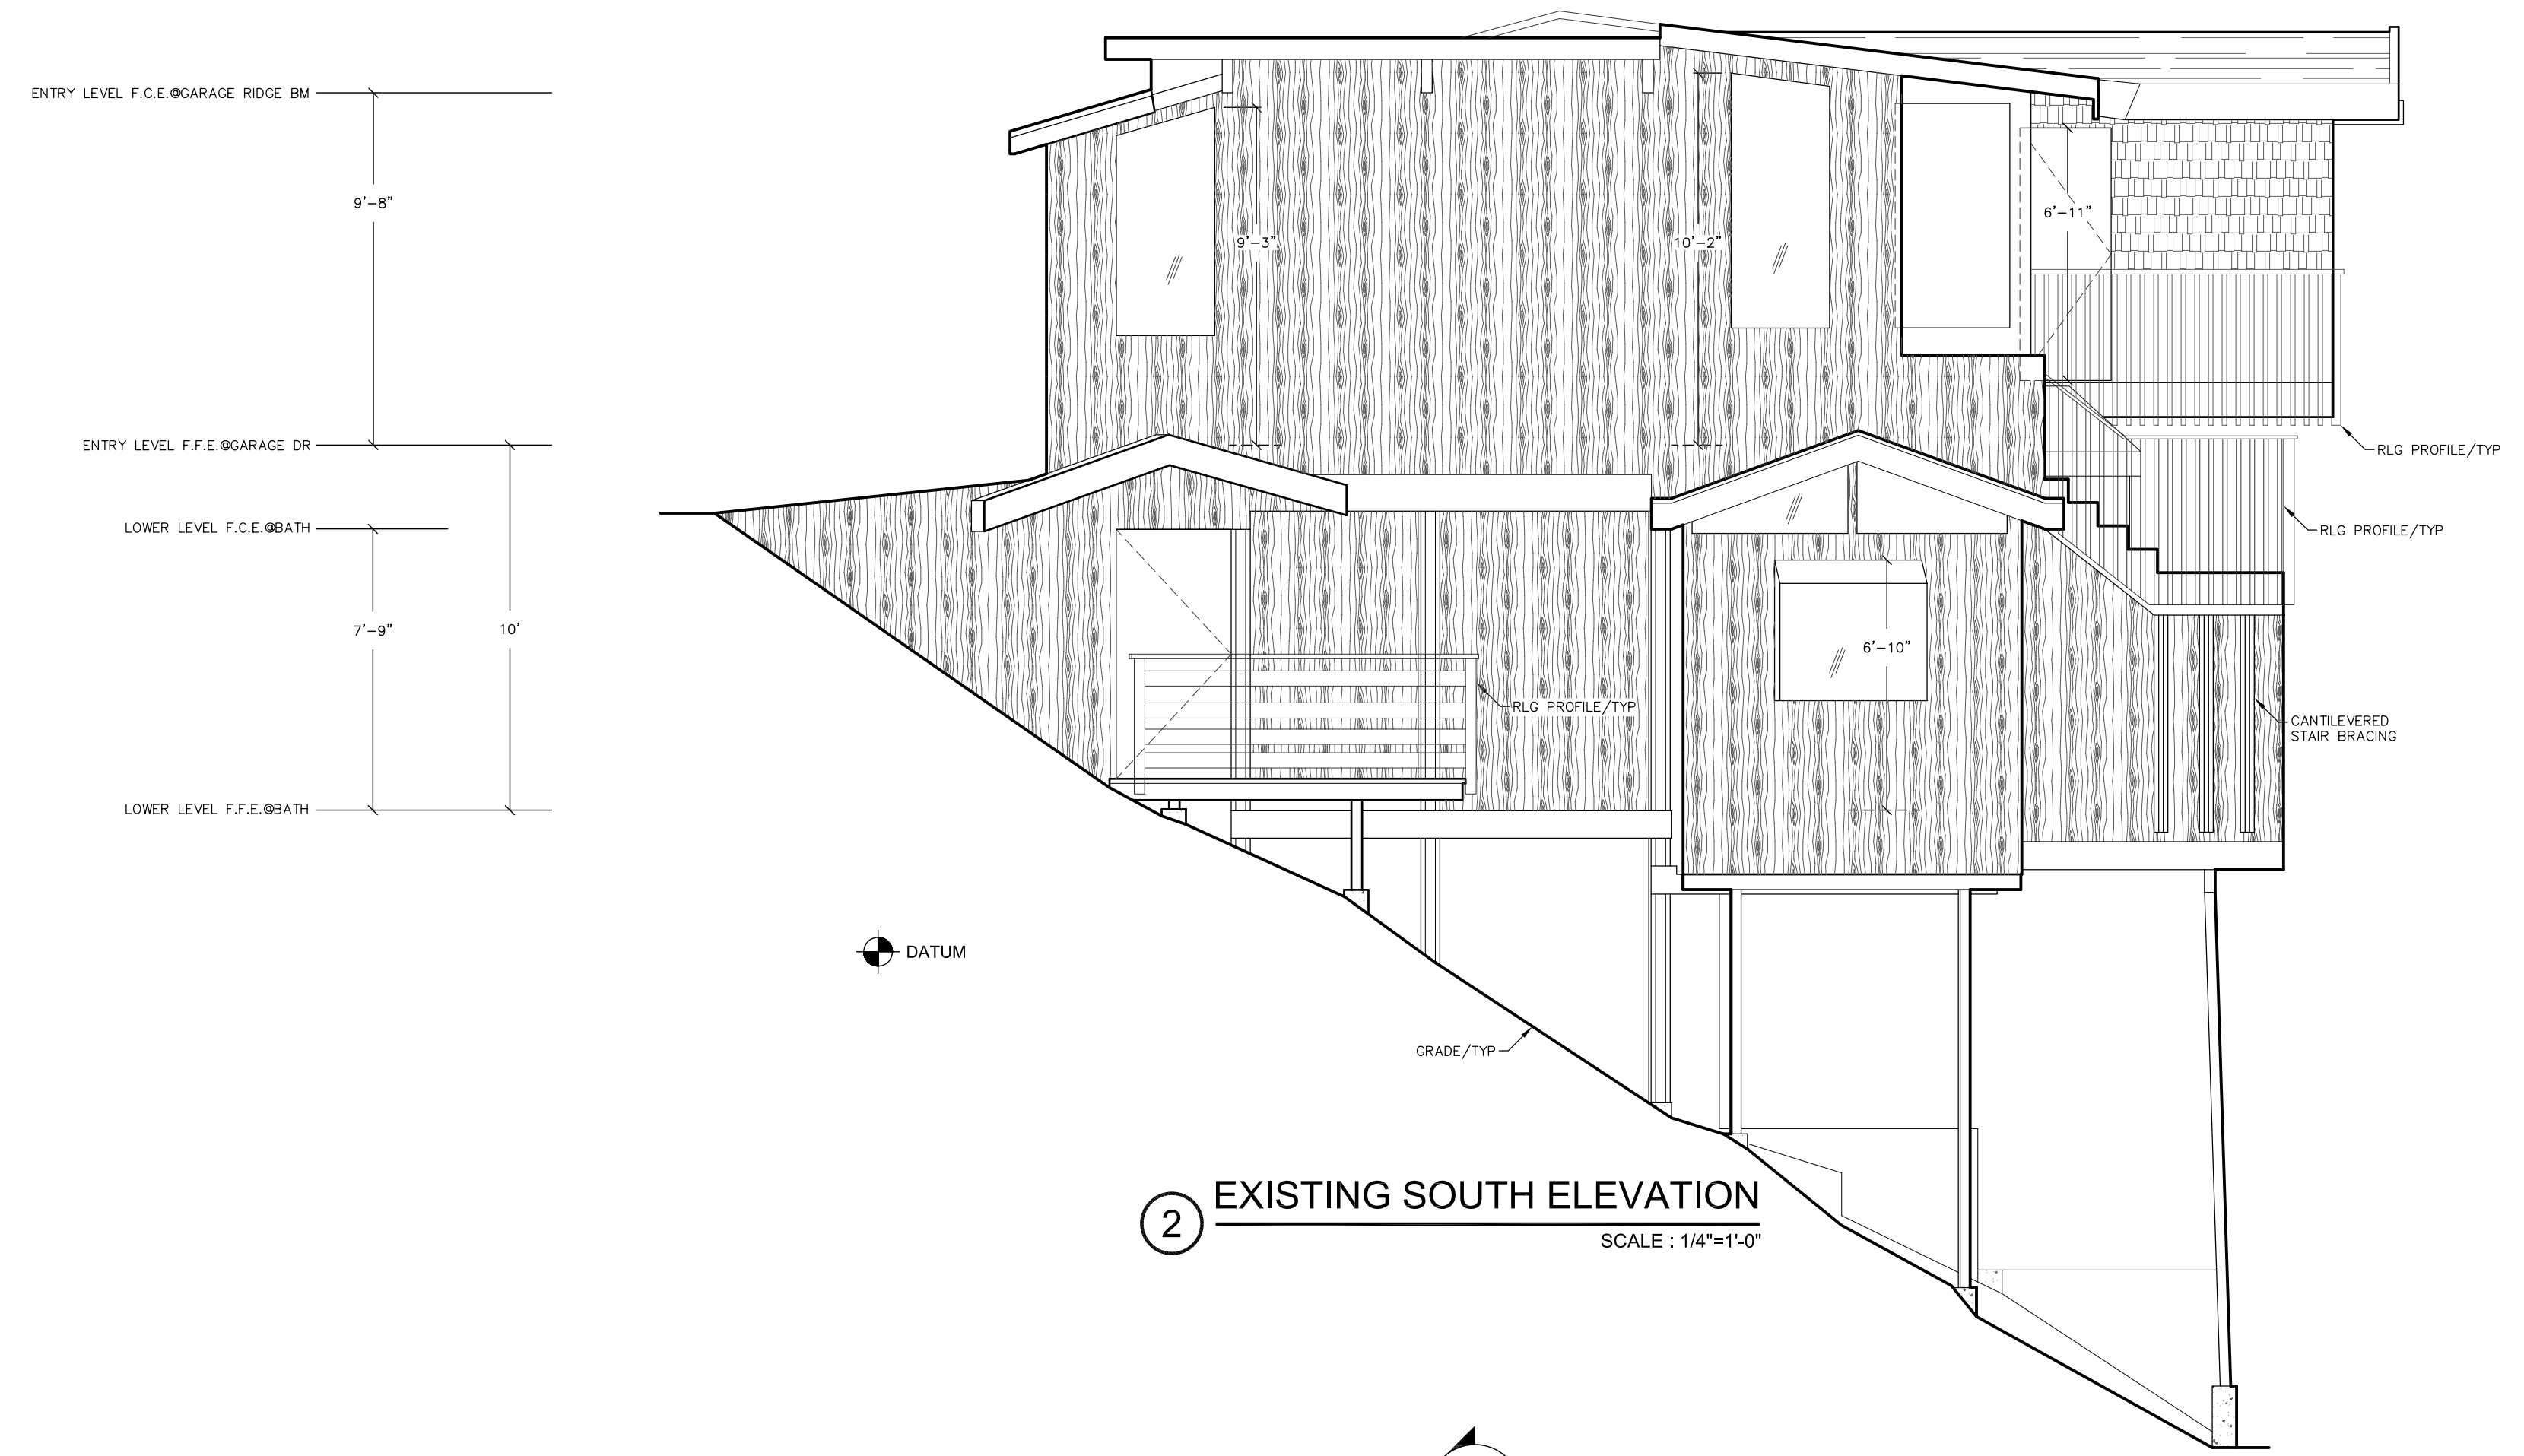

2 EXISTING SOUTH ELEVATION  
SCALE: 1/4"=1'-0"


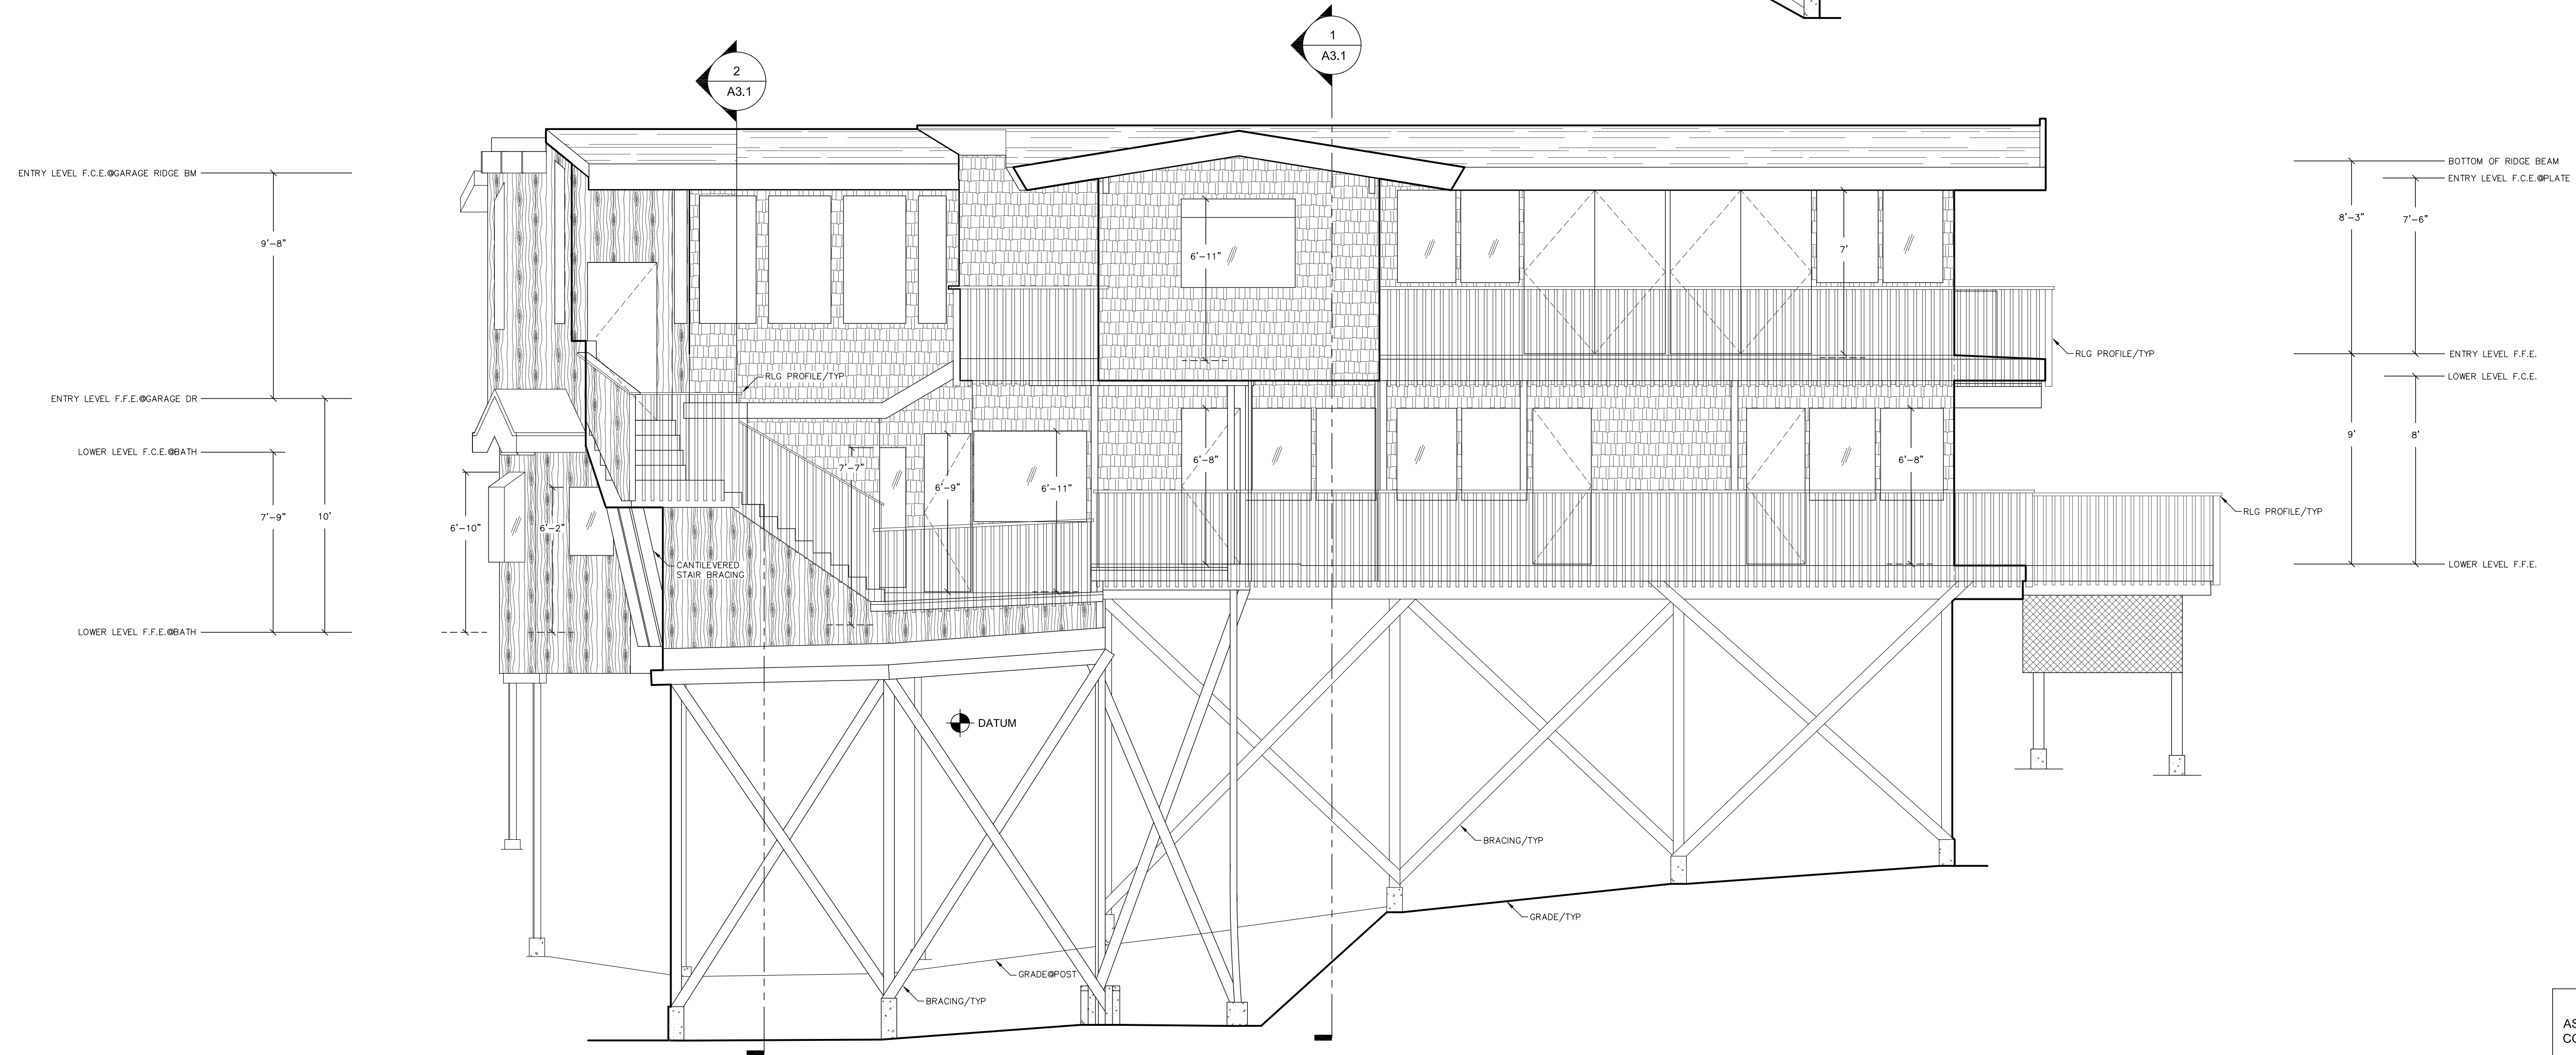


1 EXISTING EAST ELEVATION  
SCALE: 1/4"=1'-0"

EXISTING ELEVATIONS  
FOG CITY AS-BUILTS - PROVIDER OF ACCURATE AS BUILT CONDITIONS

AS BUILT DOCUMENTATION OF EXISTING  
CONDITIONS OF REAL ESTATE PROPERTY


THESE ARE BASIC ELEVATIONS.  
SINGLE LINE REPRESENTATION OF  
MAJOR STRUCTURAL ELEMENTS ONLY.

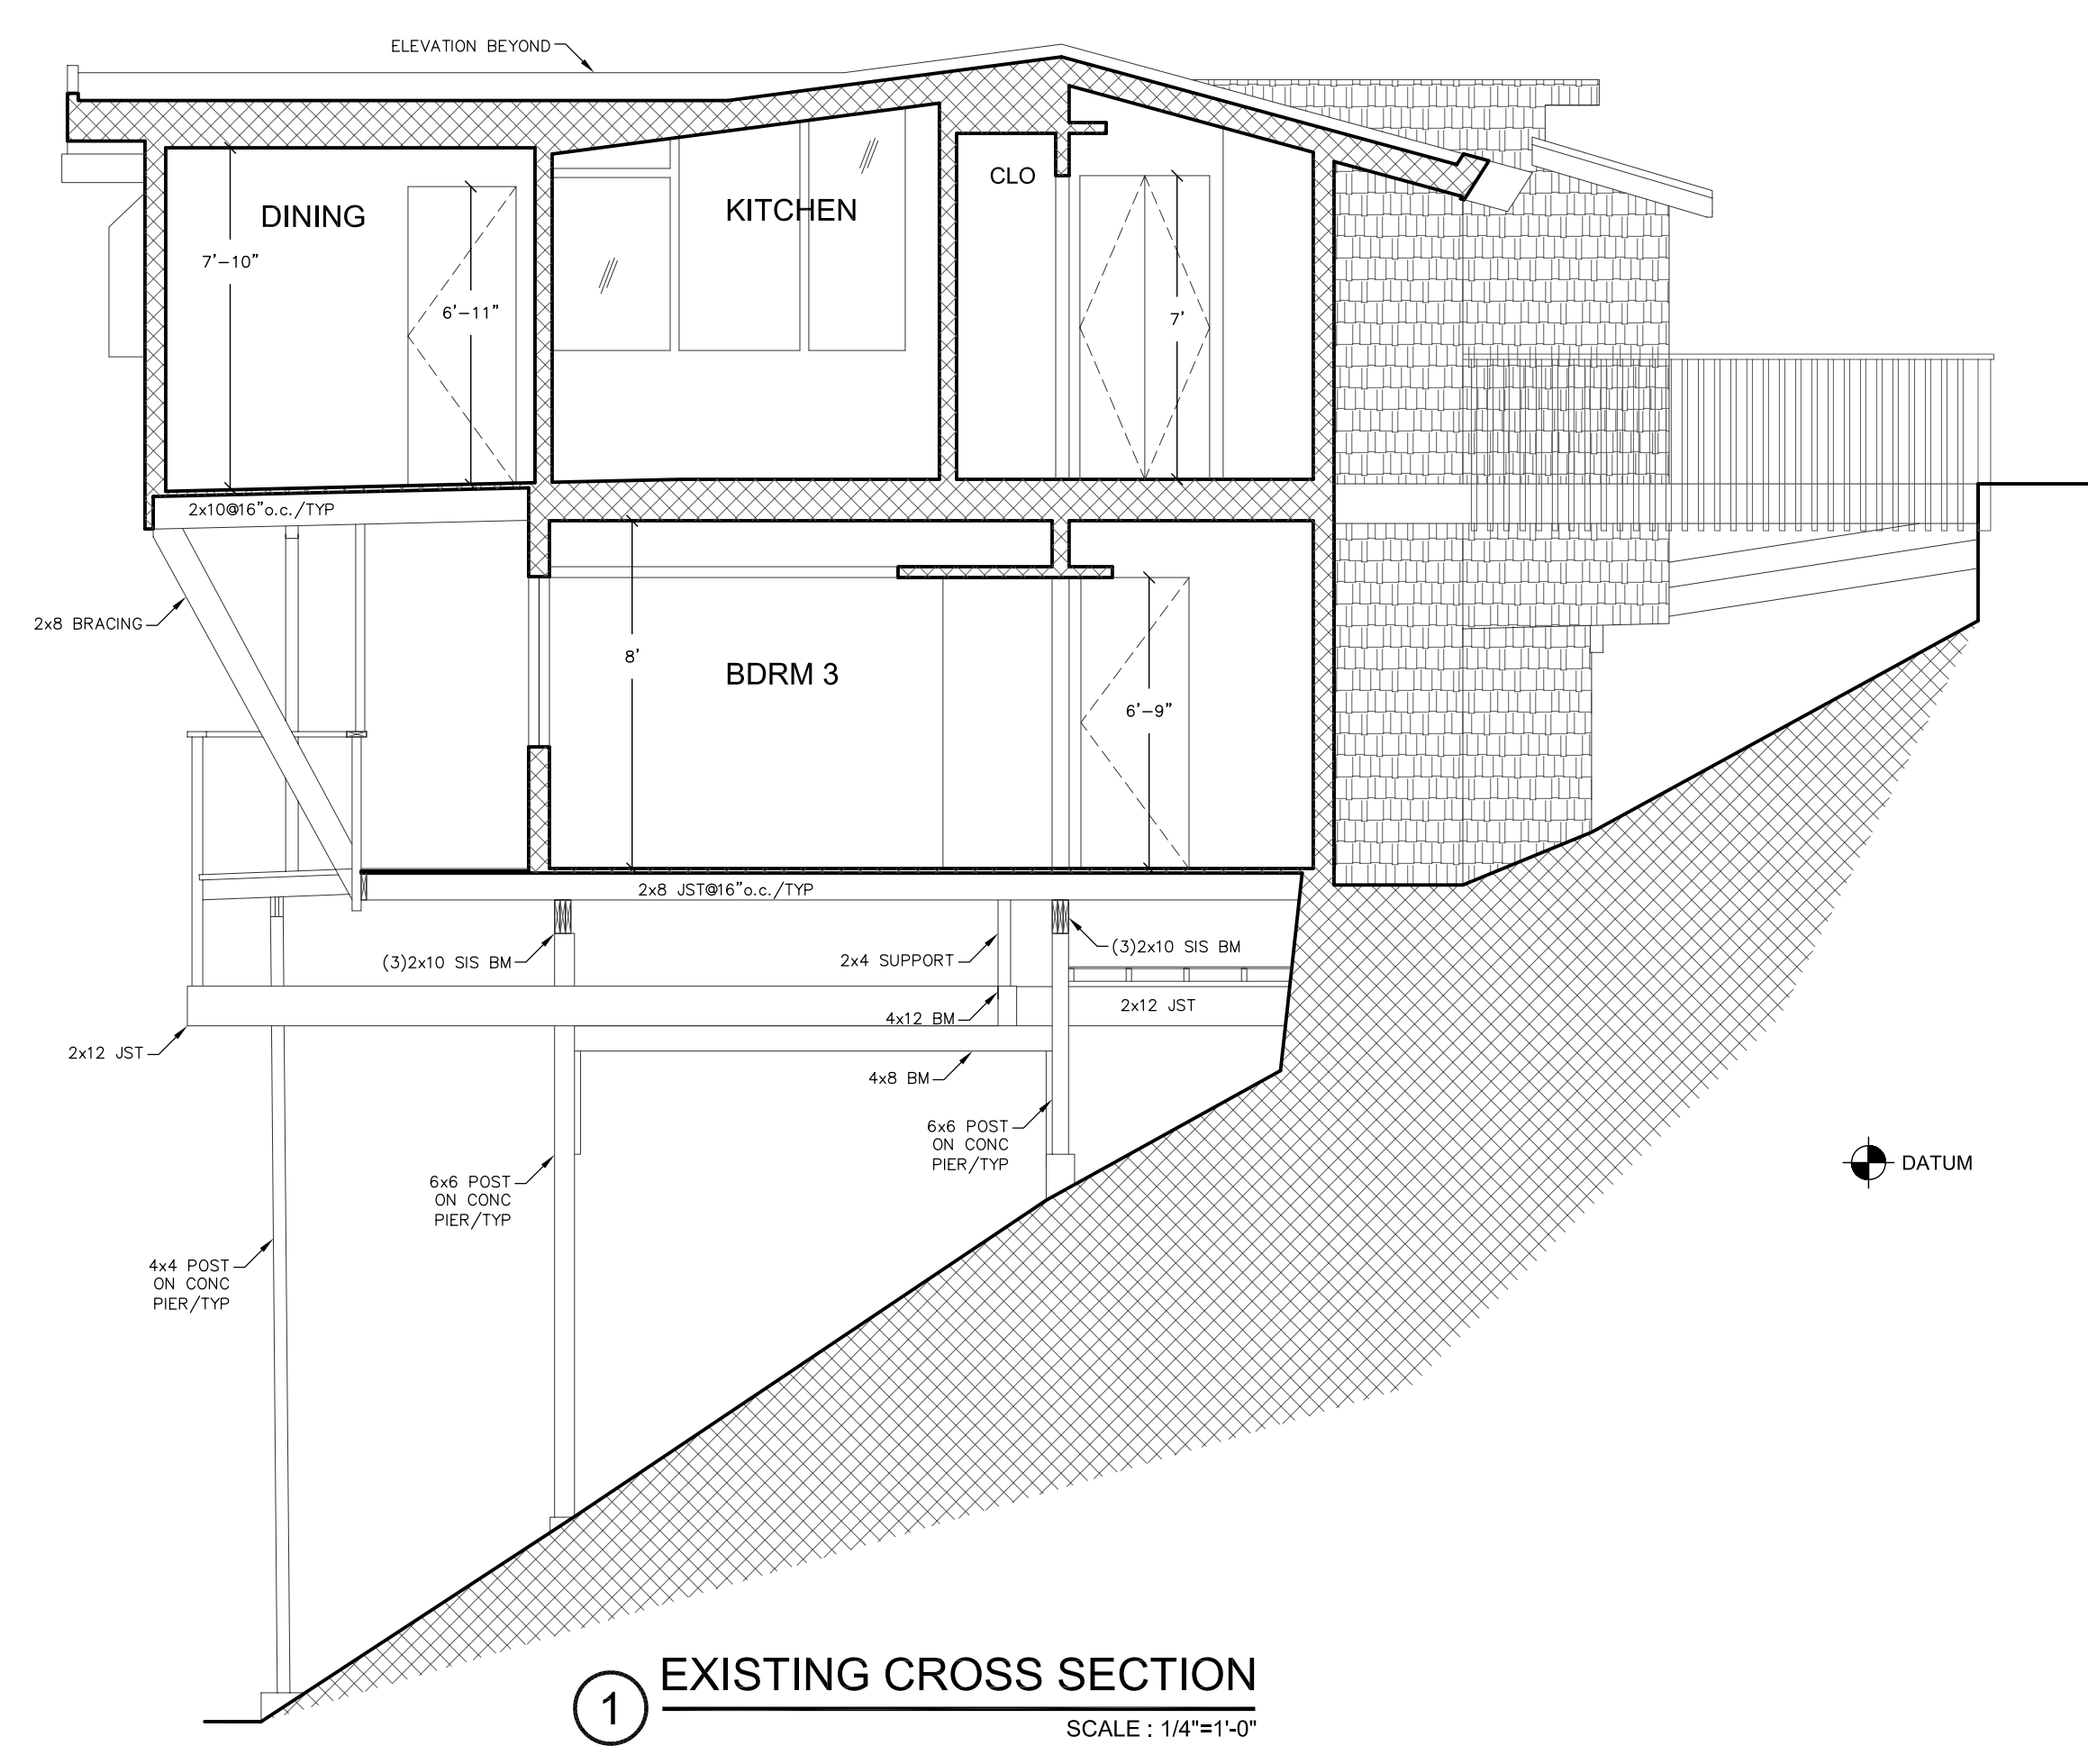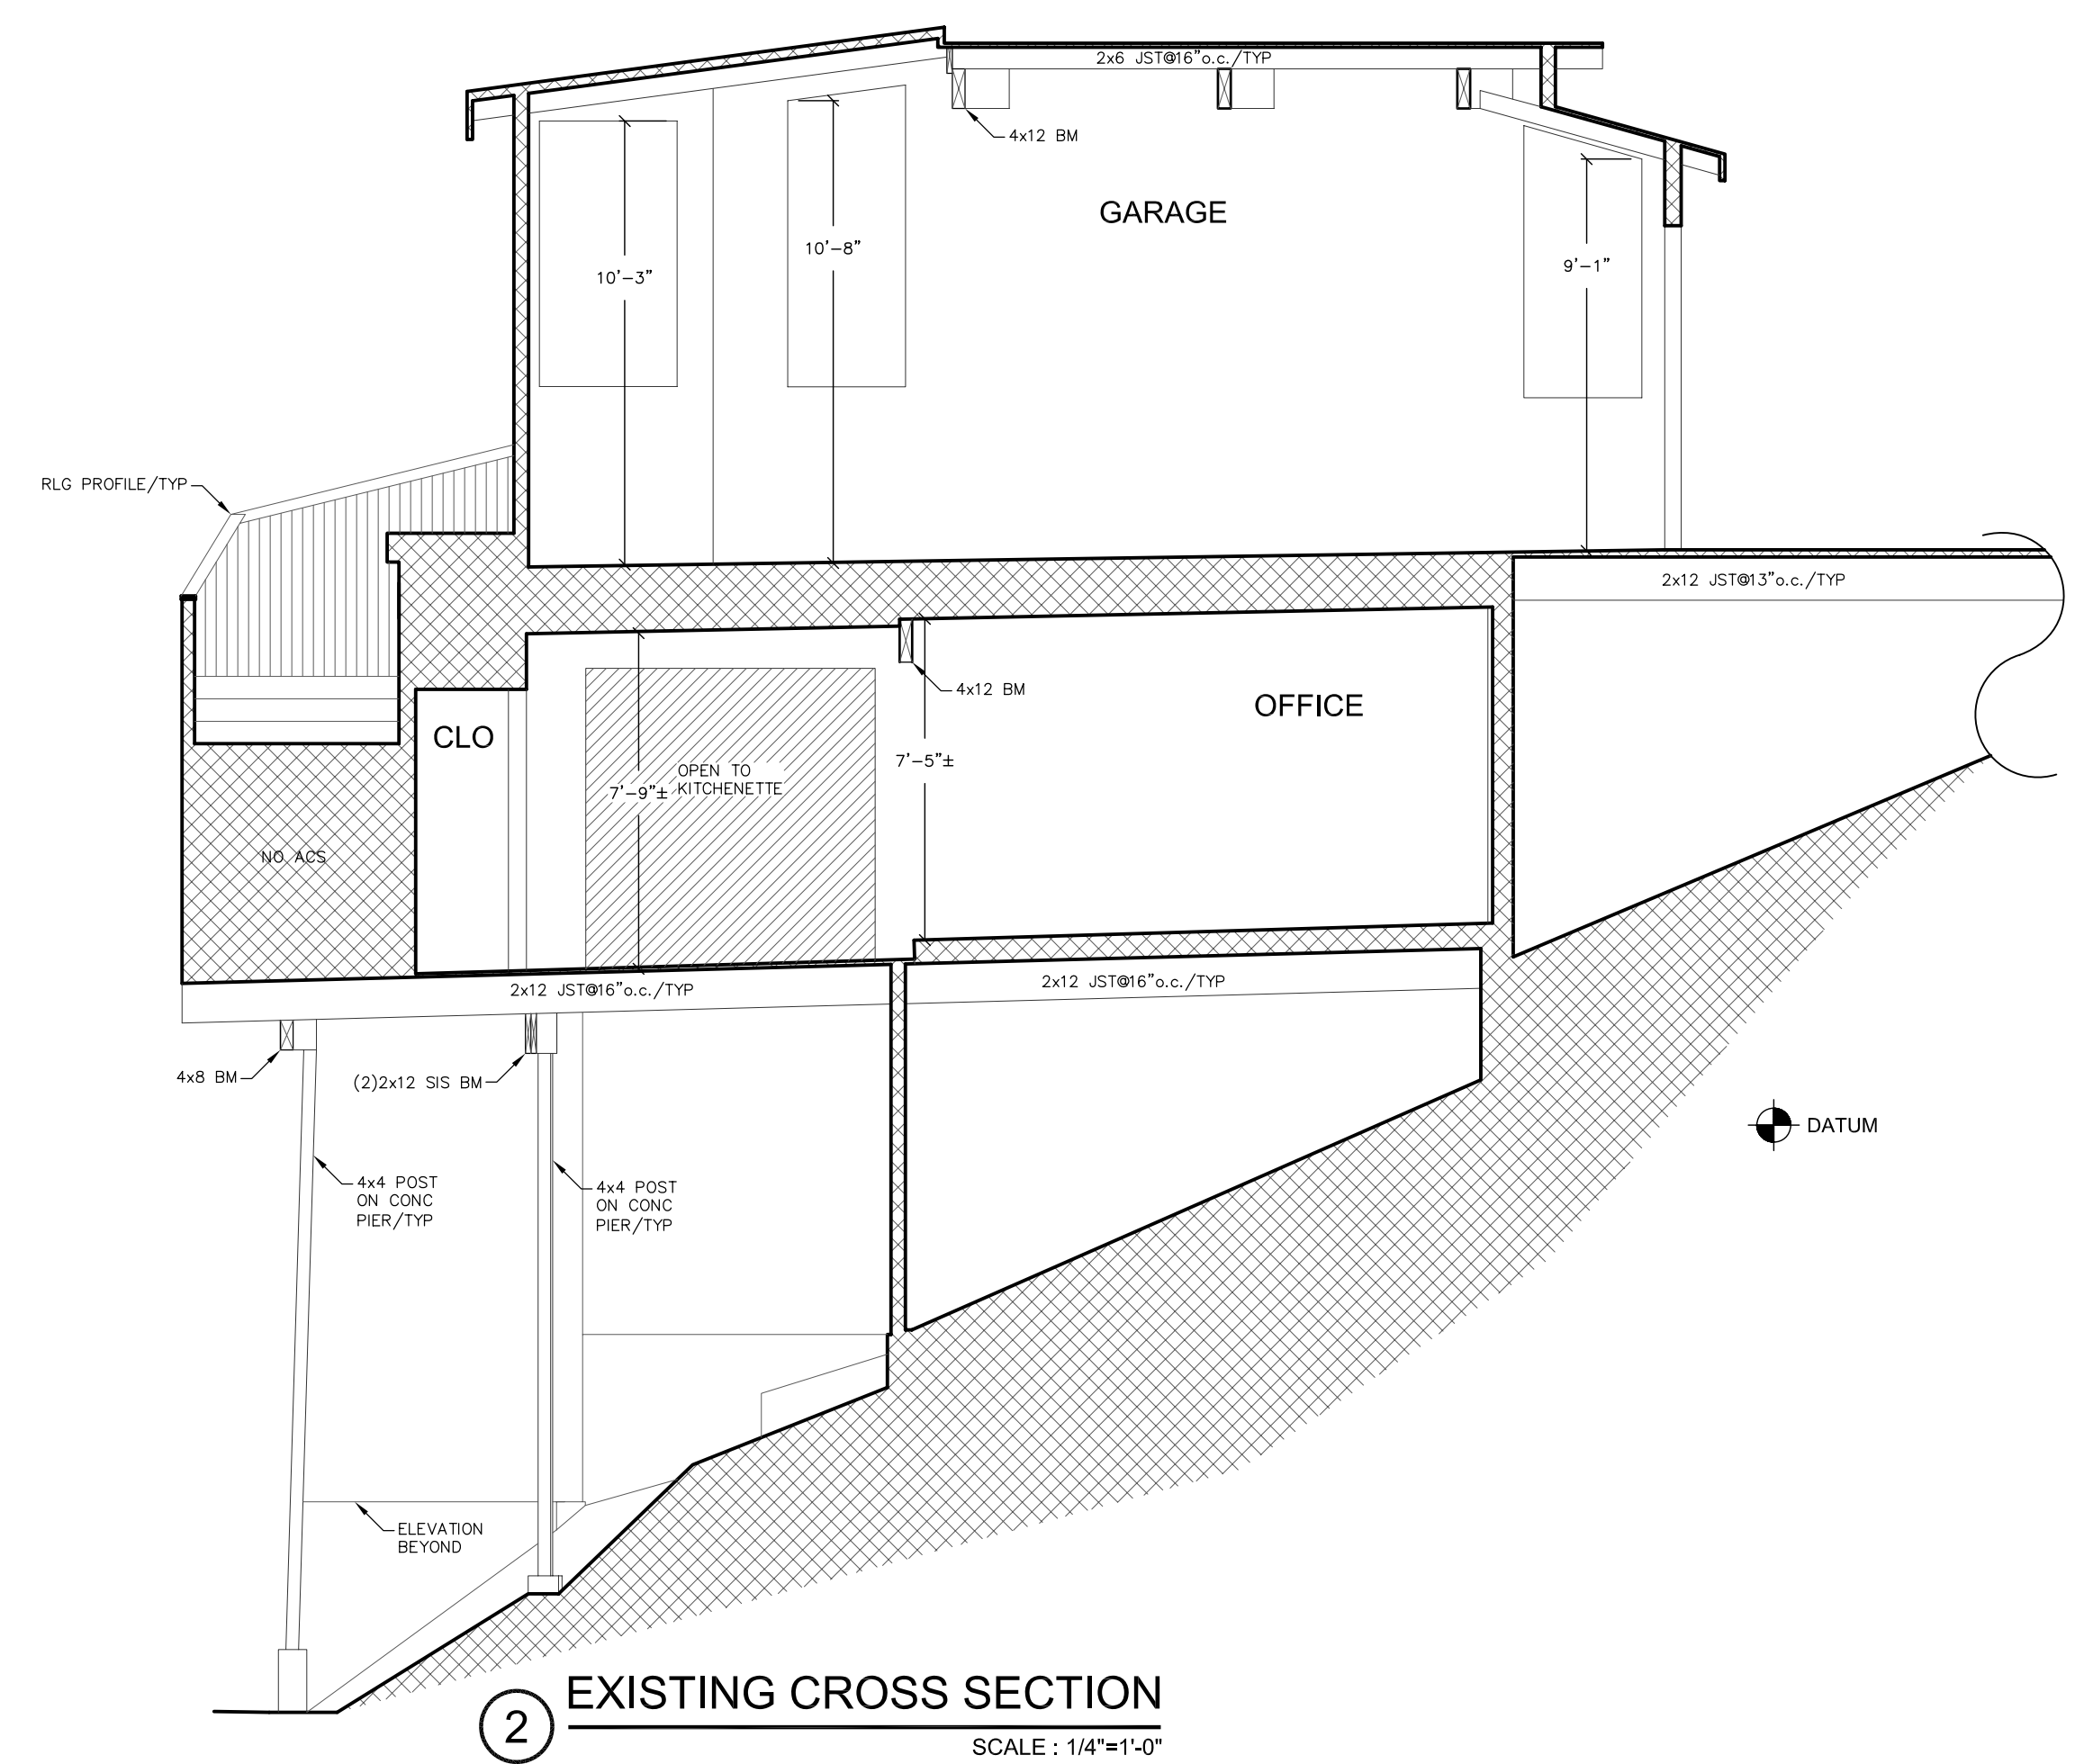

EXISTING SECTIONS  
 FOG CITY AS-BUILTS - PROVIDER OF ACCURATE AS BUILT CONDITIONS

EXISTING FOUNDATION PLAN  
FOG CITY AS-BUILTS - PROVIDER OF ACCURATE AS BUILT CONDITIONS

S1.1

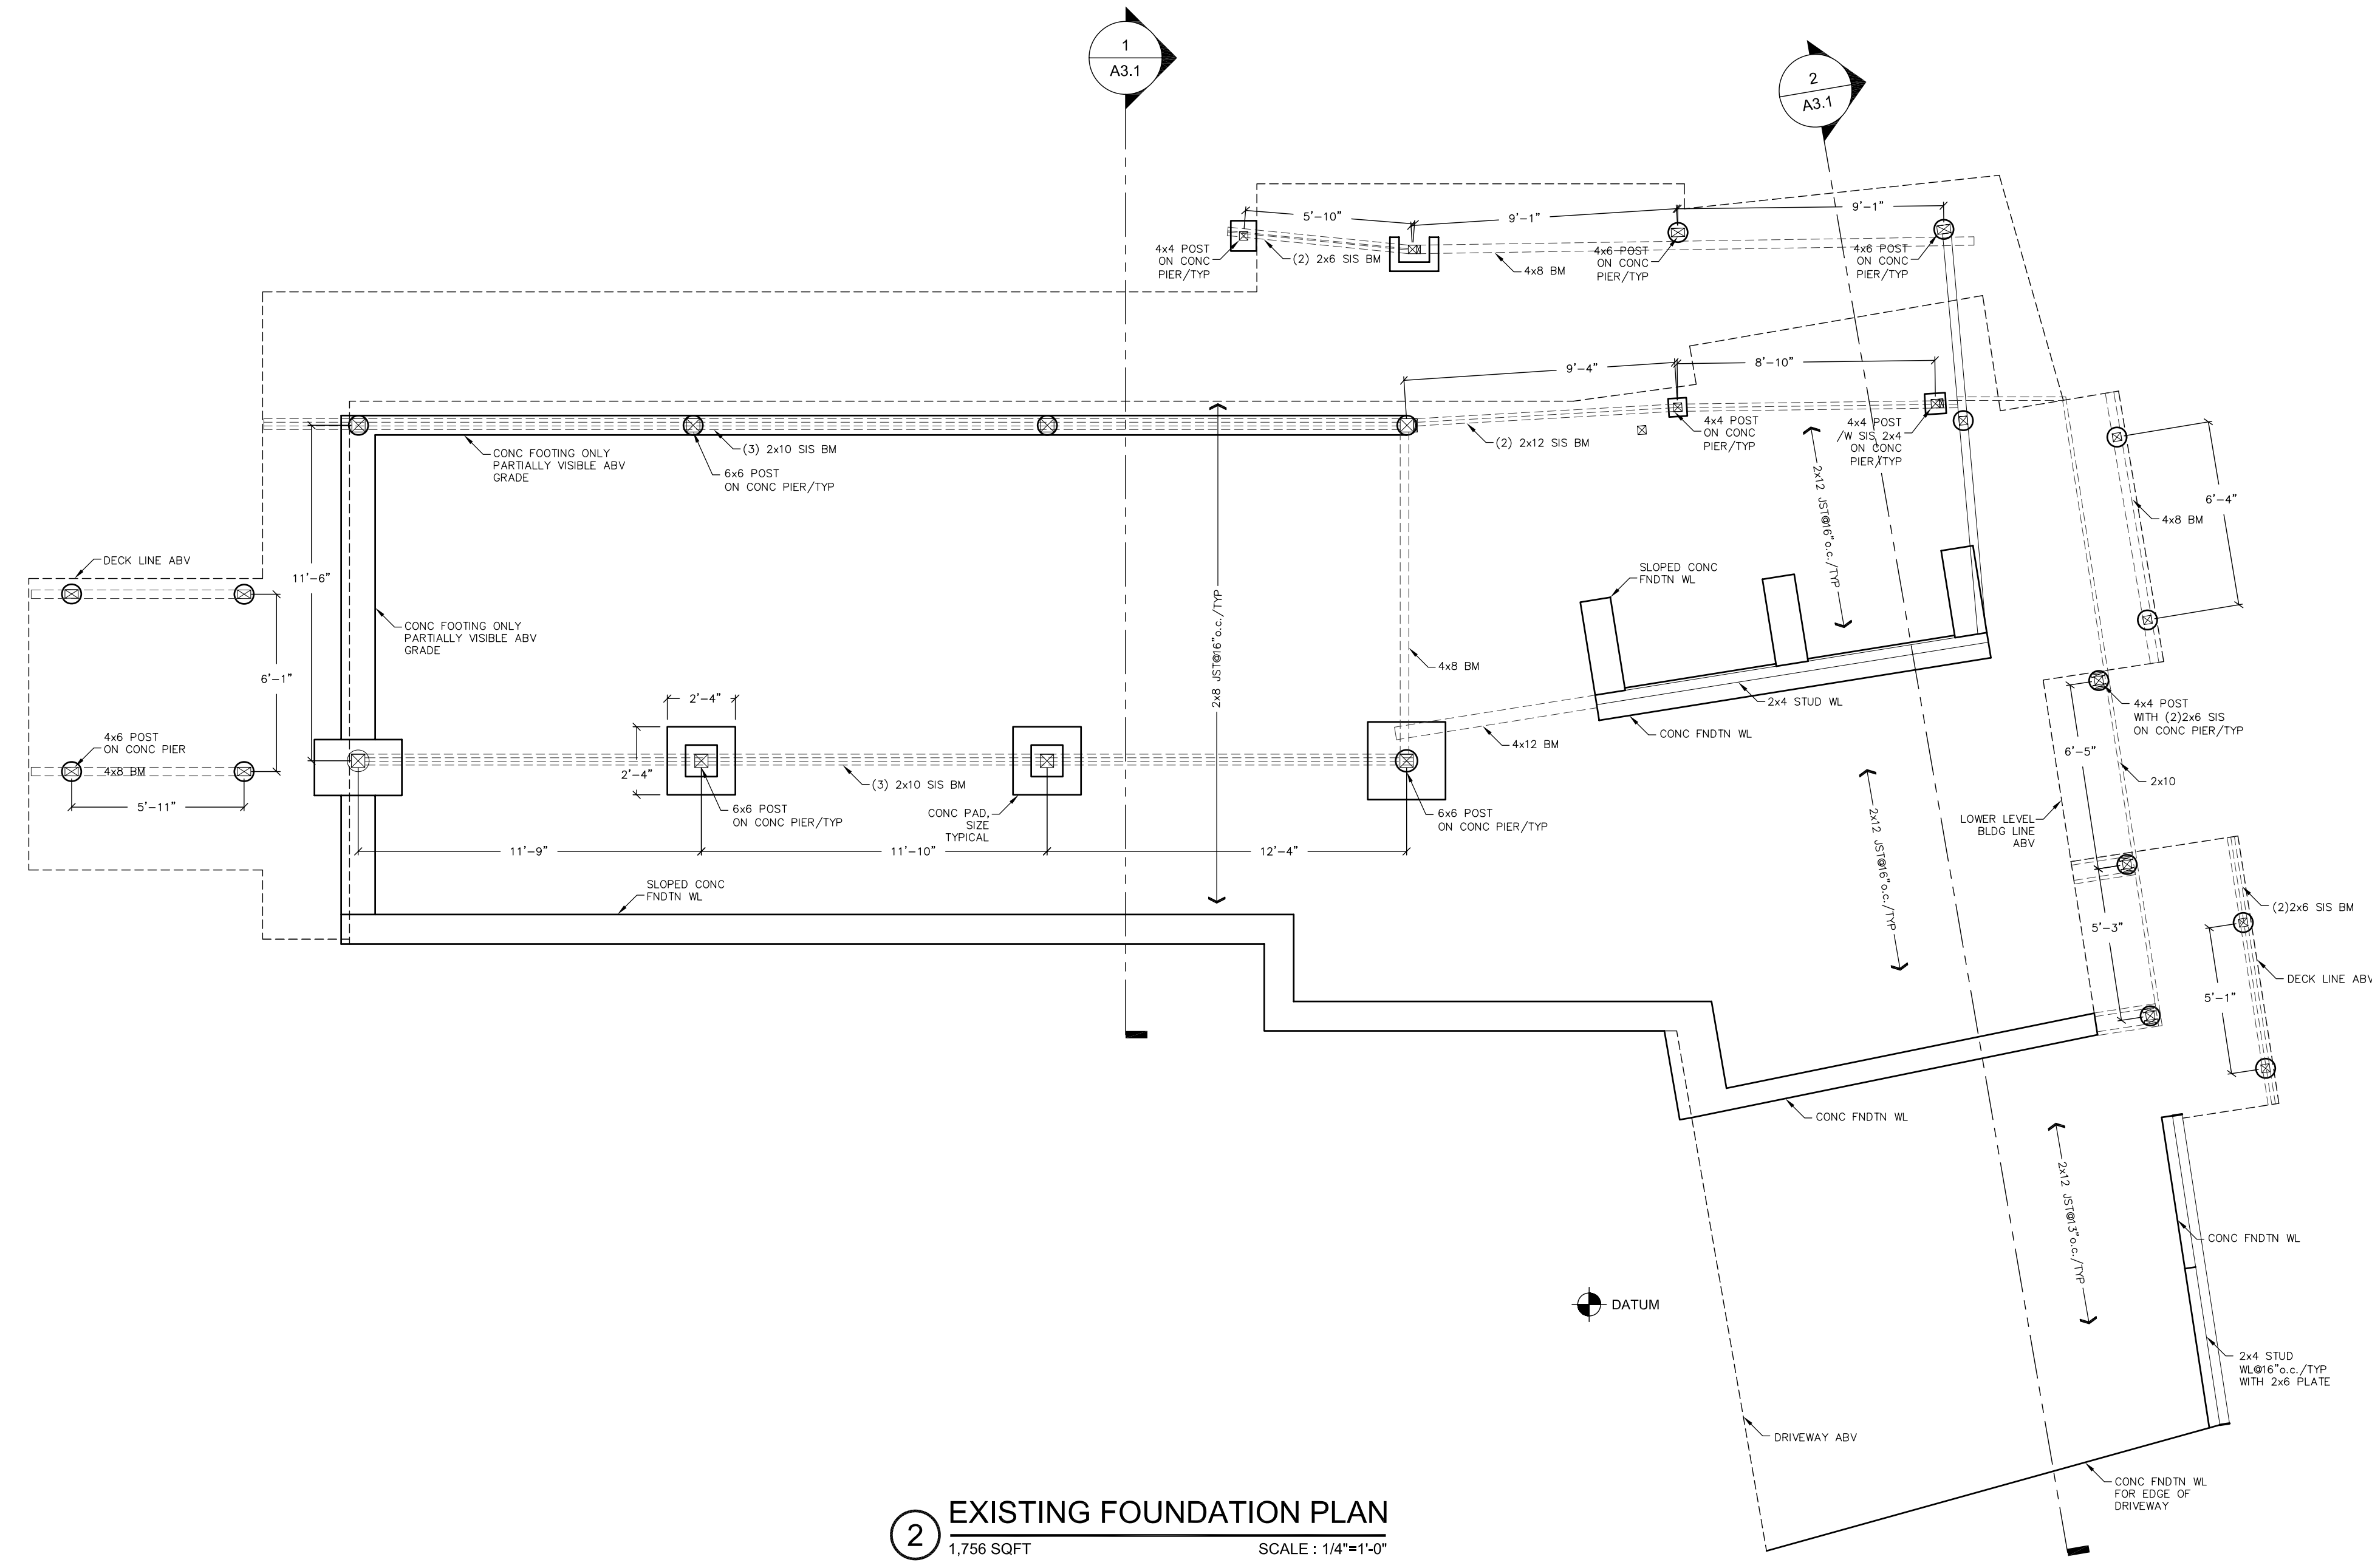

2 EXISTING FOUNDATION PLAN  
1,756 SQFT SCALE: 1/4"=1'-0"