


1 EXISTING ARCHITECTURAL SITE PLAN  
 6,952 SQFT PARCEL SCALE : 1/8"=1'-0"

EXISTING ARCHITECTURAL SITE PLAN  
 FOG CITY AS-BUILTS - PROVIDER OF ACCURATE AS BUILT CONDITIONS


AS BUILT DOCUMENTATION OF EXISTING  
 CONDITIONS OF REAL ESTATE PROPERTY

PLEASE NOTE:  
 THIS IS NOT A SURVEY. PROPERTY LINES TAKEN FROM TAX  
 ASSESSOR'S MAP. PLACEMENT ASSUMED.

A0.1

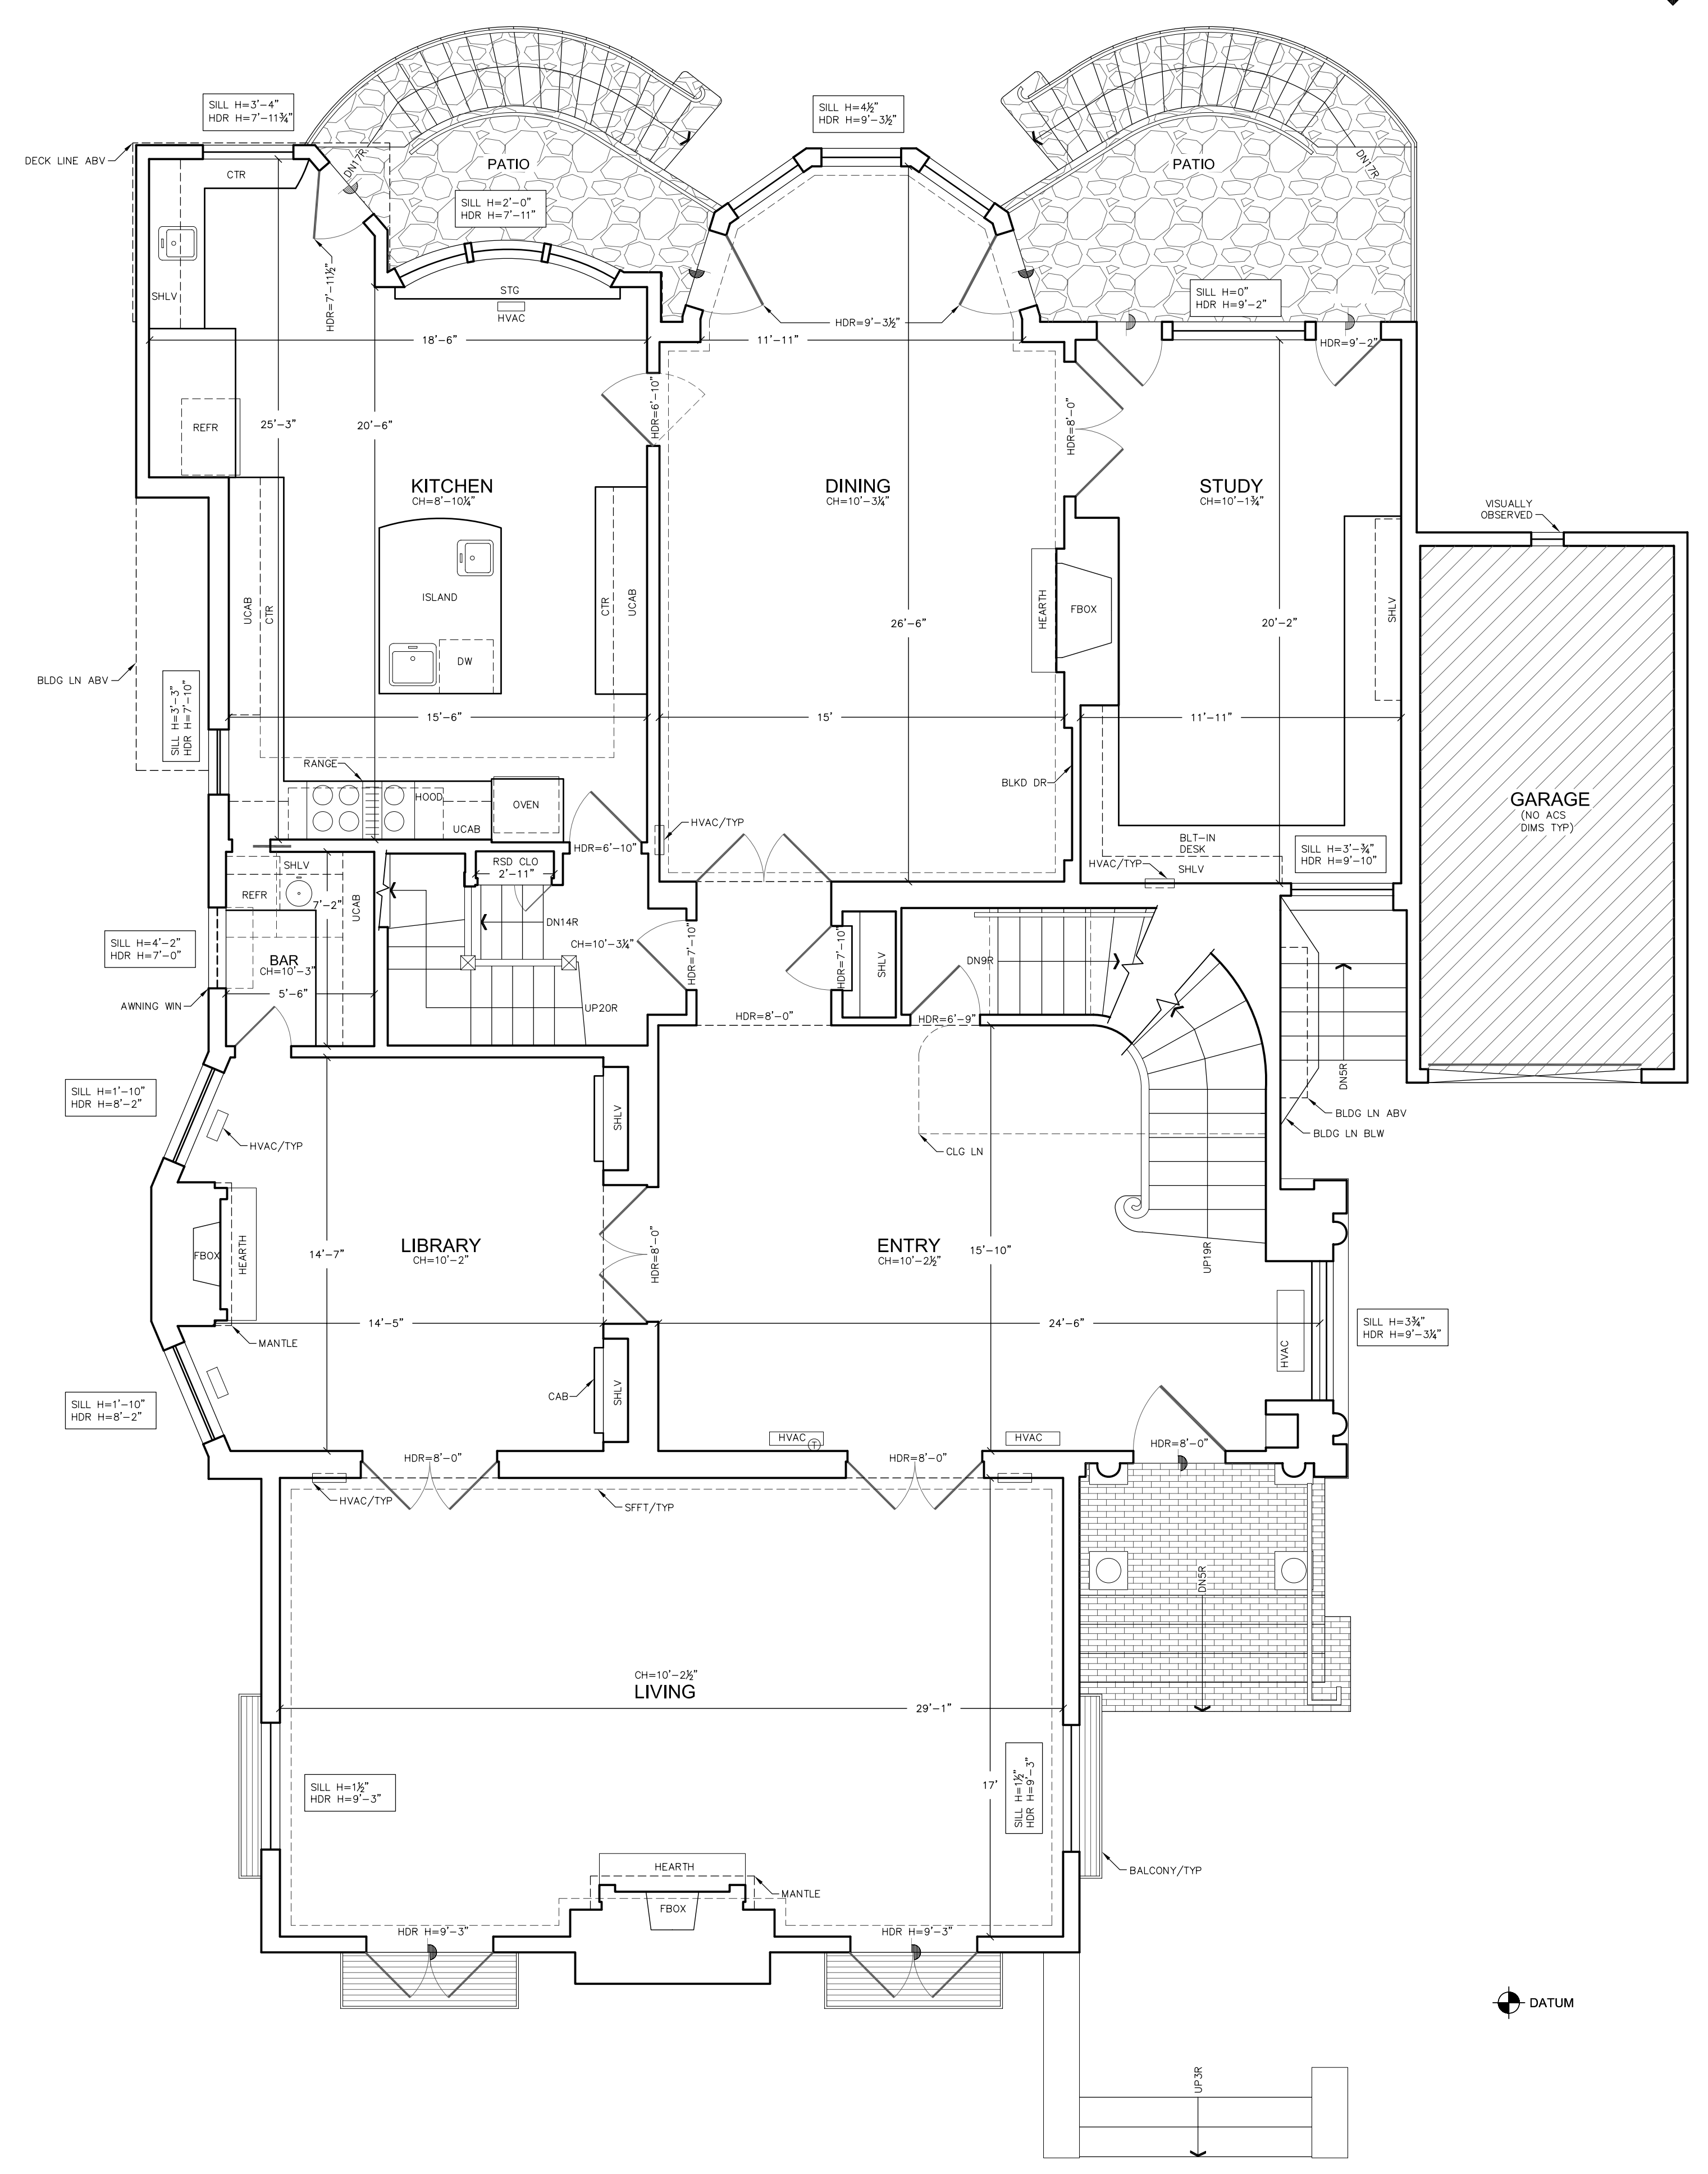


2 EXISTING ENTRY LEVEL FLOOR PLAN  
 2,772 SQFT INTERIOR  
 371 SQFT EXTERIOR  
 SCALE : 1/4"=1'-0"

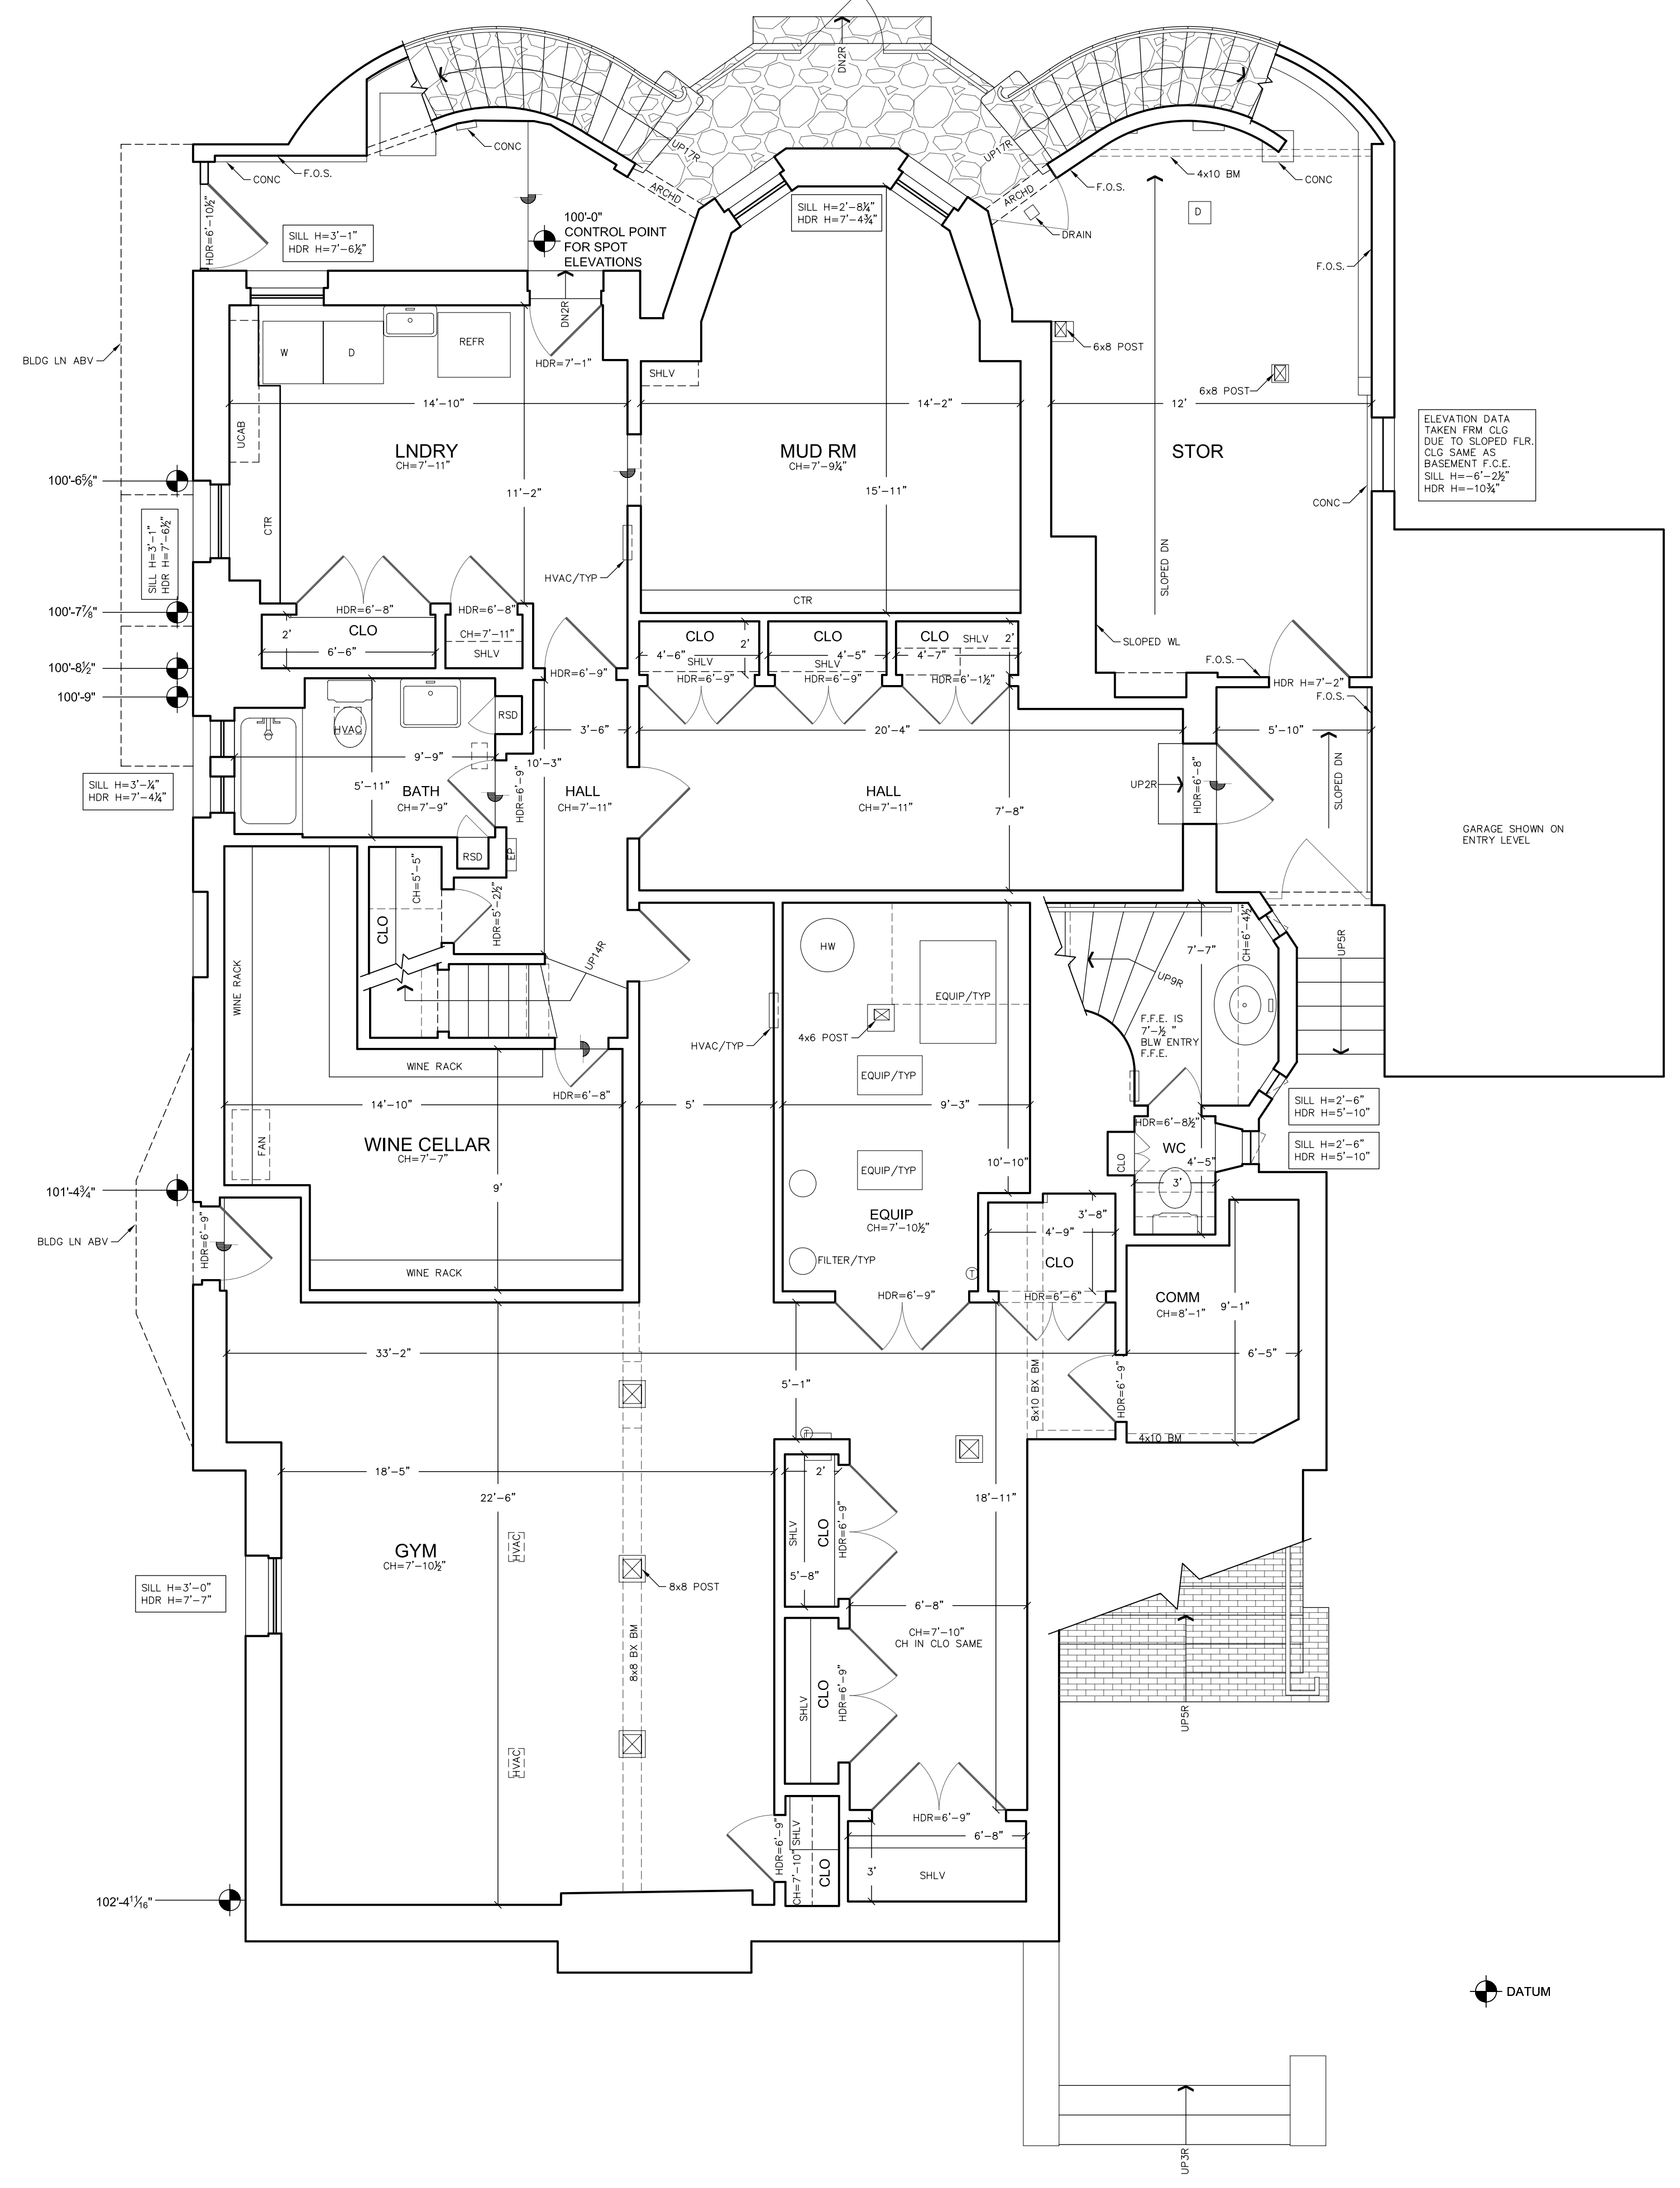

1 EXISTING BASEMENT LEVEL FLOOR PLAN  
 2,652 SQFT INTERIOR  
 79 SQFT EXTERIOR  
 SCALE : 1/4"=1'-0"

EXISTING FLOOR PLANS  
 FOG CITY AS-BUILTS - PROVIDER OF ACCURATE AS BUILT CONDITIONS

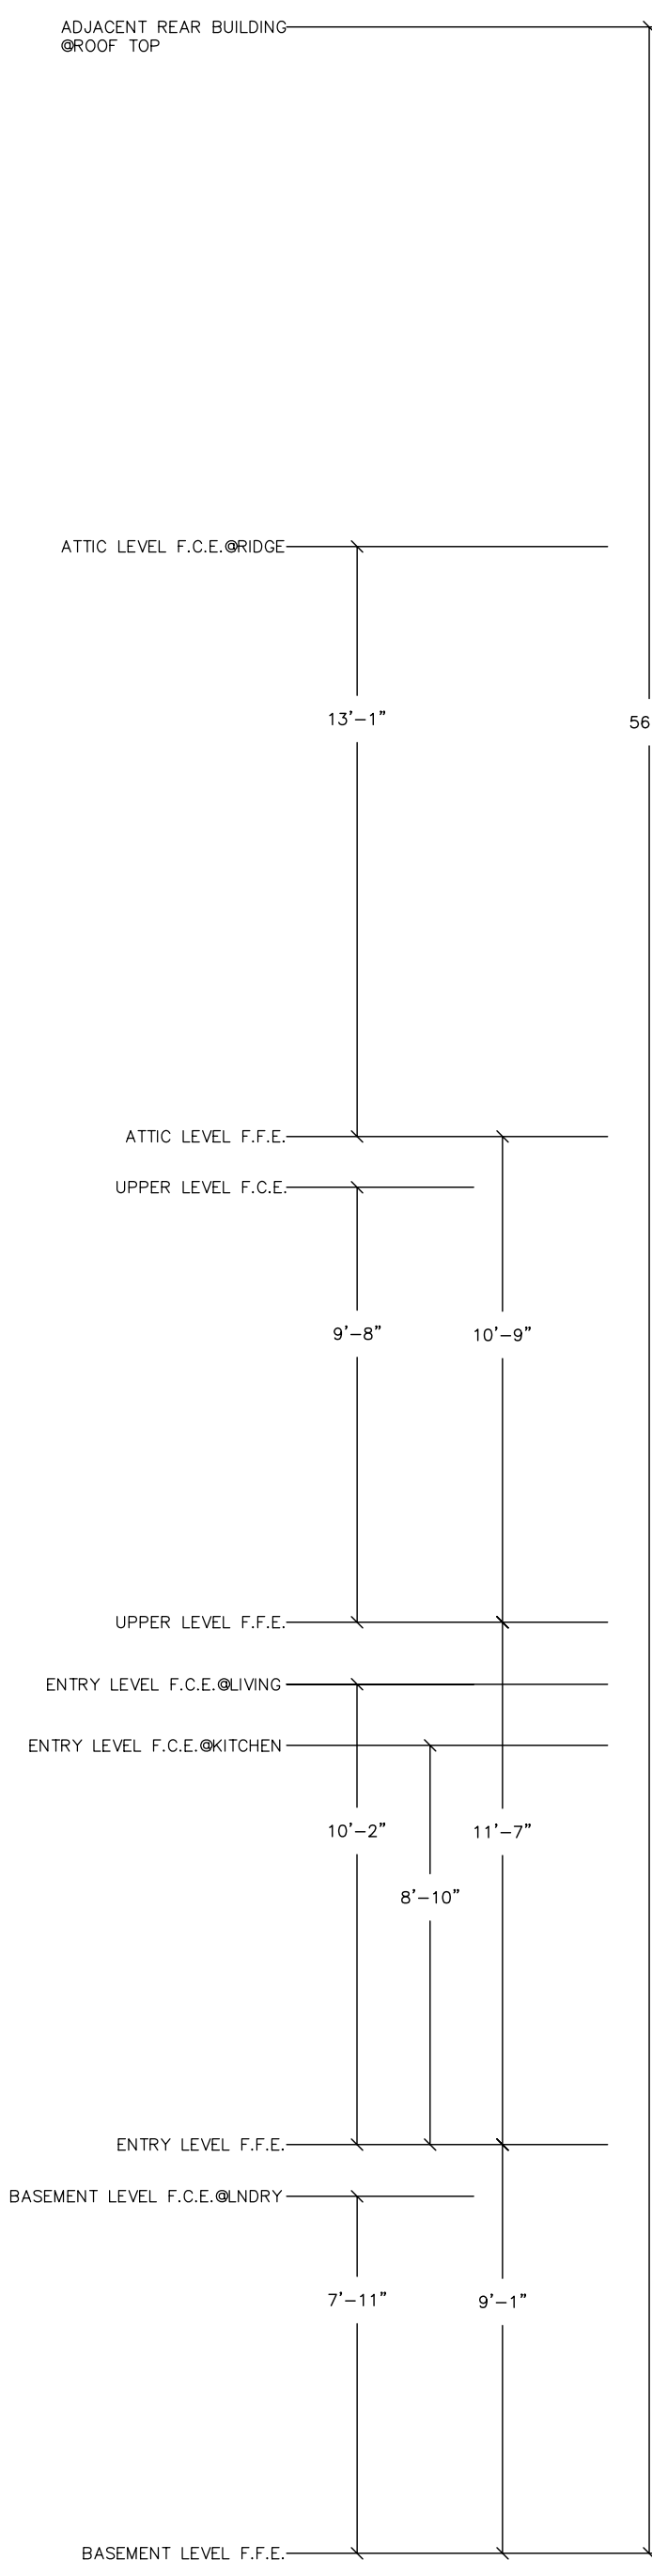

1 EXISTING NORTH ELEVATION  
SCALE : 1/4"=1'-0"

EXISTING ELEVATION

FOG CITY AS-BUILTS - PROVIDER OF ACCURATE AS BUILT CONDITIONS

A2.2