

2
A2.1

3
A2.1

4
A2.1

1
A2.1


2 EXISTING ENTRY LEVEL FLOOR PLAN
 3,210 SQFT INTERIOR
 1,815 SQFT EXTERIOR
 SCALE : 1/4"=1'-0"

1 EXISTING LOWER LEVEL FLOOR PLAN
 307 SQFT INTERIOR
 SCALE : 1/4"=1'-0"


EXISTING FLOOR PLANS

FOG CITY AS-BUILTS - PROVIDER OF ACCURATE AS BUILT CONDITIONS


A1.1

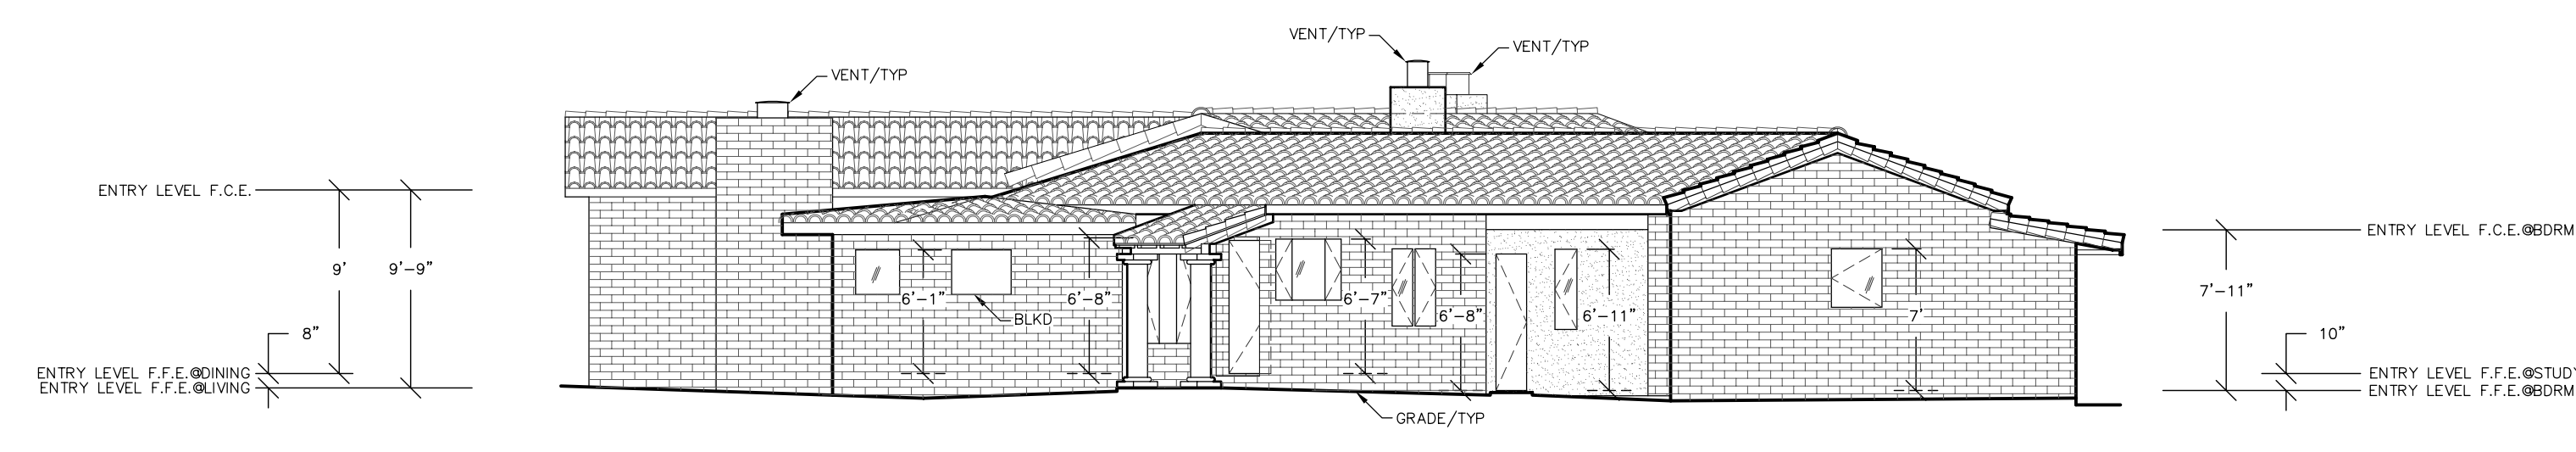


4 EXISTING EAST ELEVATION
 SCALE : 1/8"=1'-0"

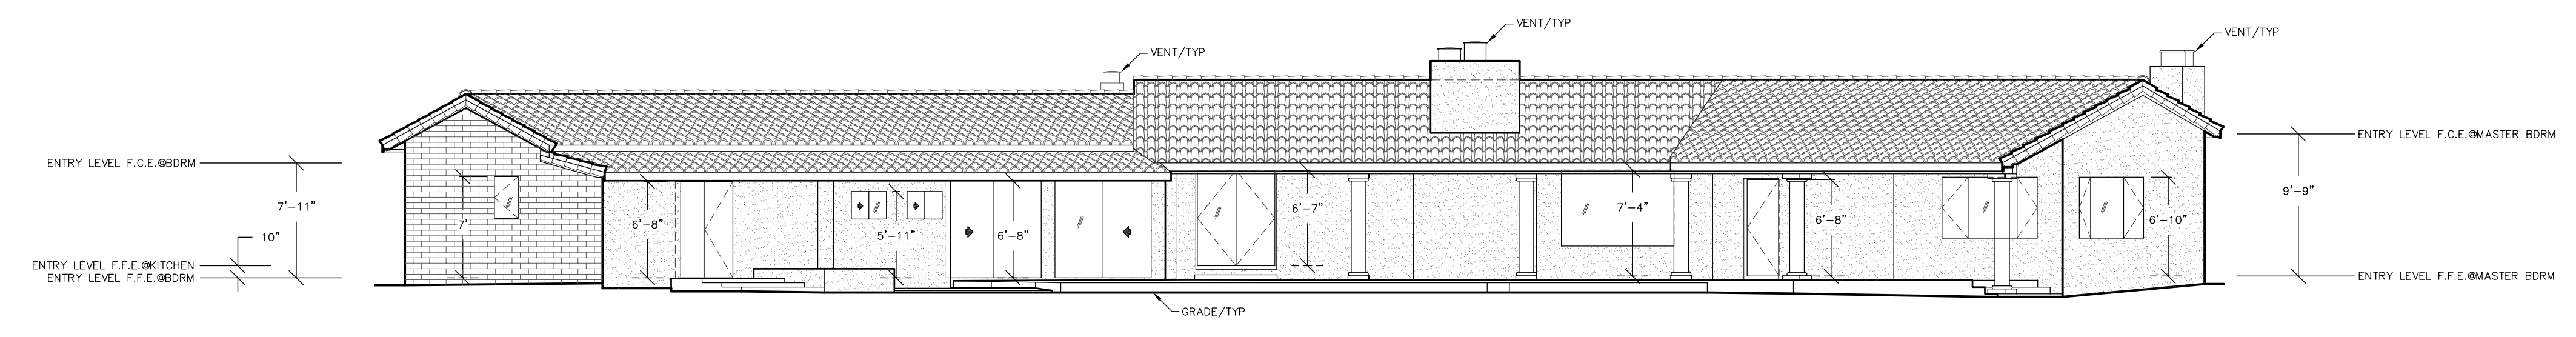

3 EXISTING NORTH ELEVATION
 SCALE : 1/8"=1'-0"

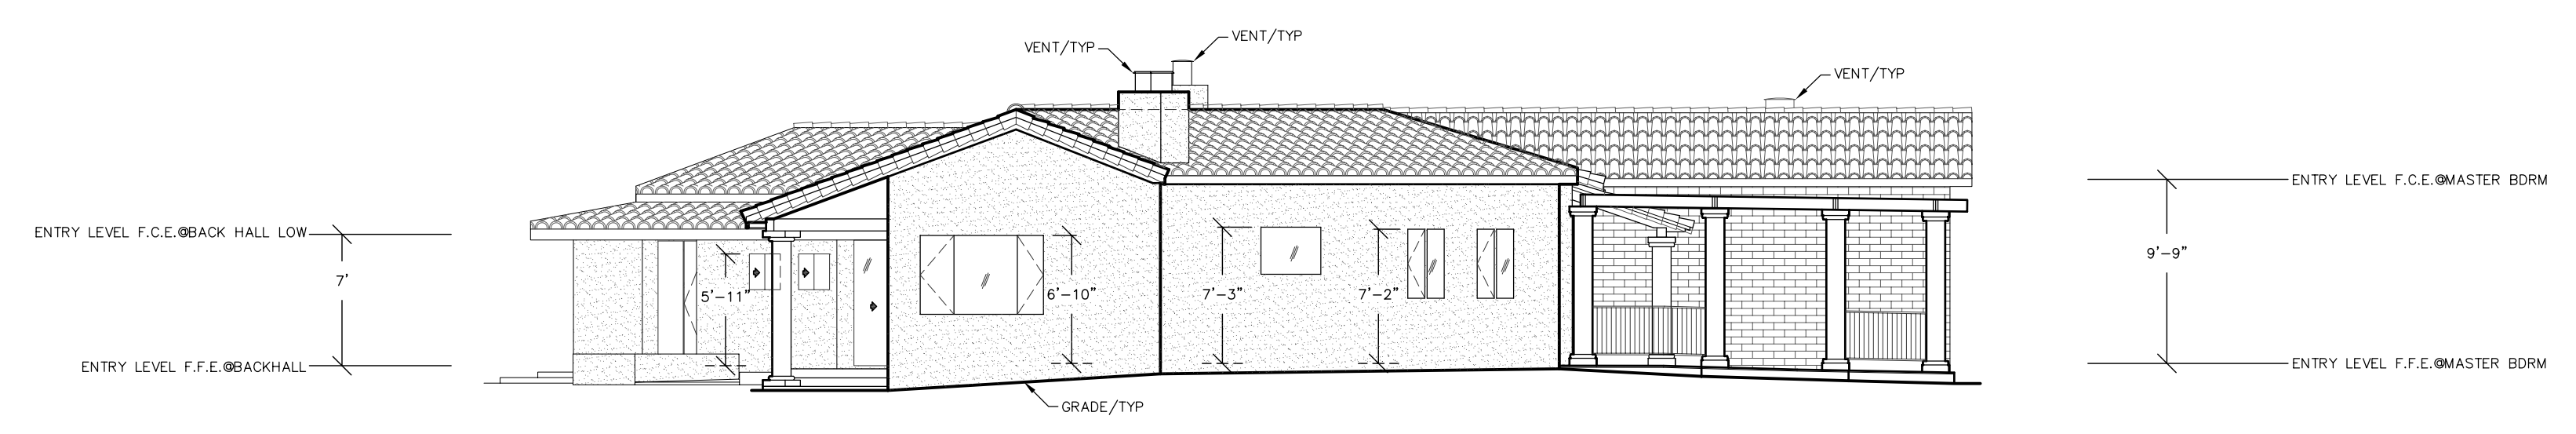

2 EXISTING EAST ELEVATION
 SCALE : 1/8"=1'-0"

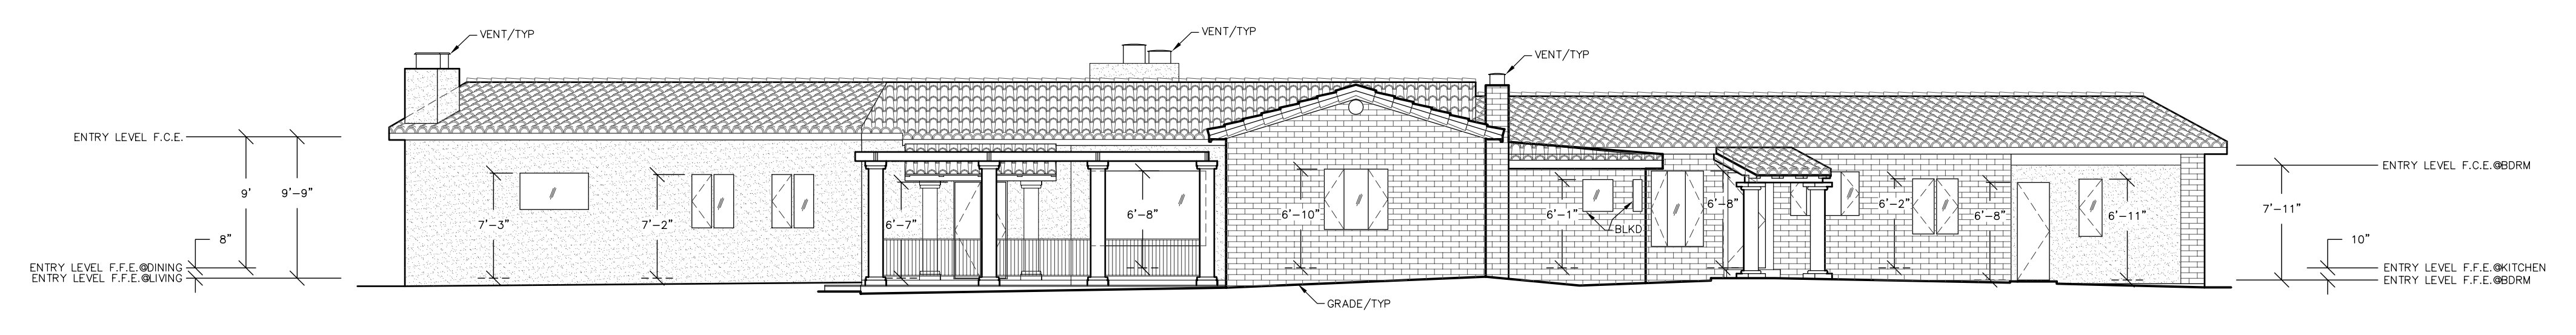

1 EXISTING SOUTH ELEVATION
 SCALE : 1/8"=1'-0"

EXISTING ELEVATIONS
 FOG CITY AS-BUILTS - PROVIDER OF ACCURATE AS BUILT CONDITIONS

AS BUILT DOCUMENTATION OF EXISTING
 CONDITIONS OF REAL ESTATE PROPERTY
 THESE ARE BASIC ELEVATIONS.
 SINGLE LINE REPRESENTATION OF
 MAJOR STRUCTURAL ELEMENTS ONLY.