


1 EXISTING ARCHITECTURAL SITE PLAN  
 18,000 SQFT PROPERTY LINE SCALE: 1/8"=1'-0"

PLEASE NOTE:  
 100'-0" CONTROL POINT FOR SPOT ELEVATIONS IS LOCATED AT FINISHED FLOOR AT FRONT ENTRY DOOR.


PLEASE NOTE:  
 THIS IS NOT A SURVEY. PROPERTY LINES TAKEN FROM TAX ASSESSOR'S MAP. PLACEMENT ASSUMED.

EXISTING ARCHITECTURAL SITE PLAN  
 CALISTOGA, CA. 94515

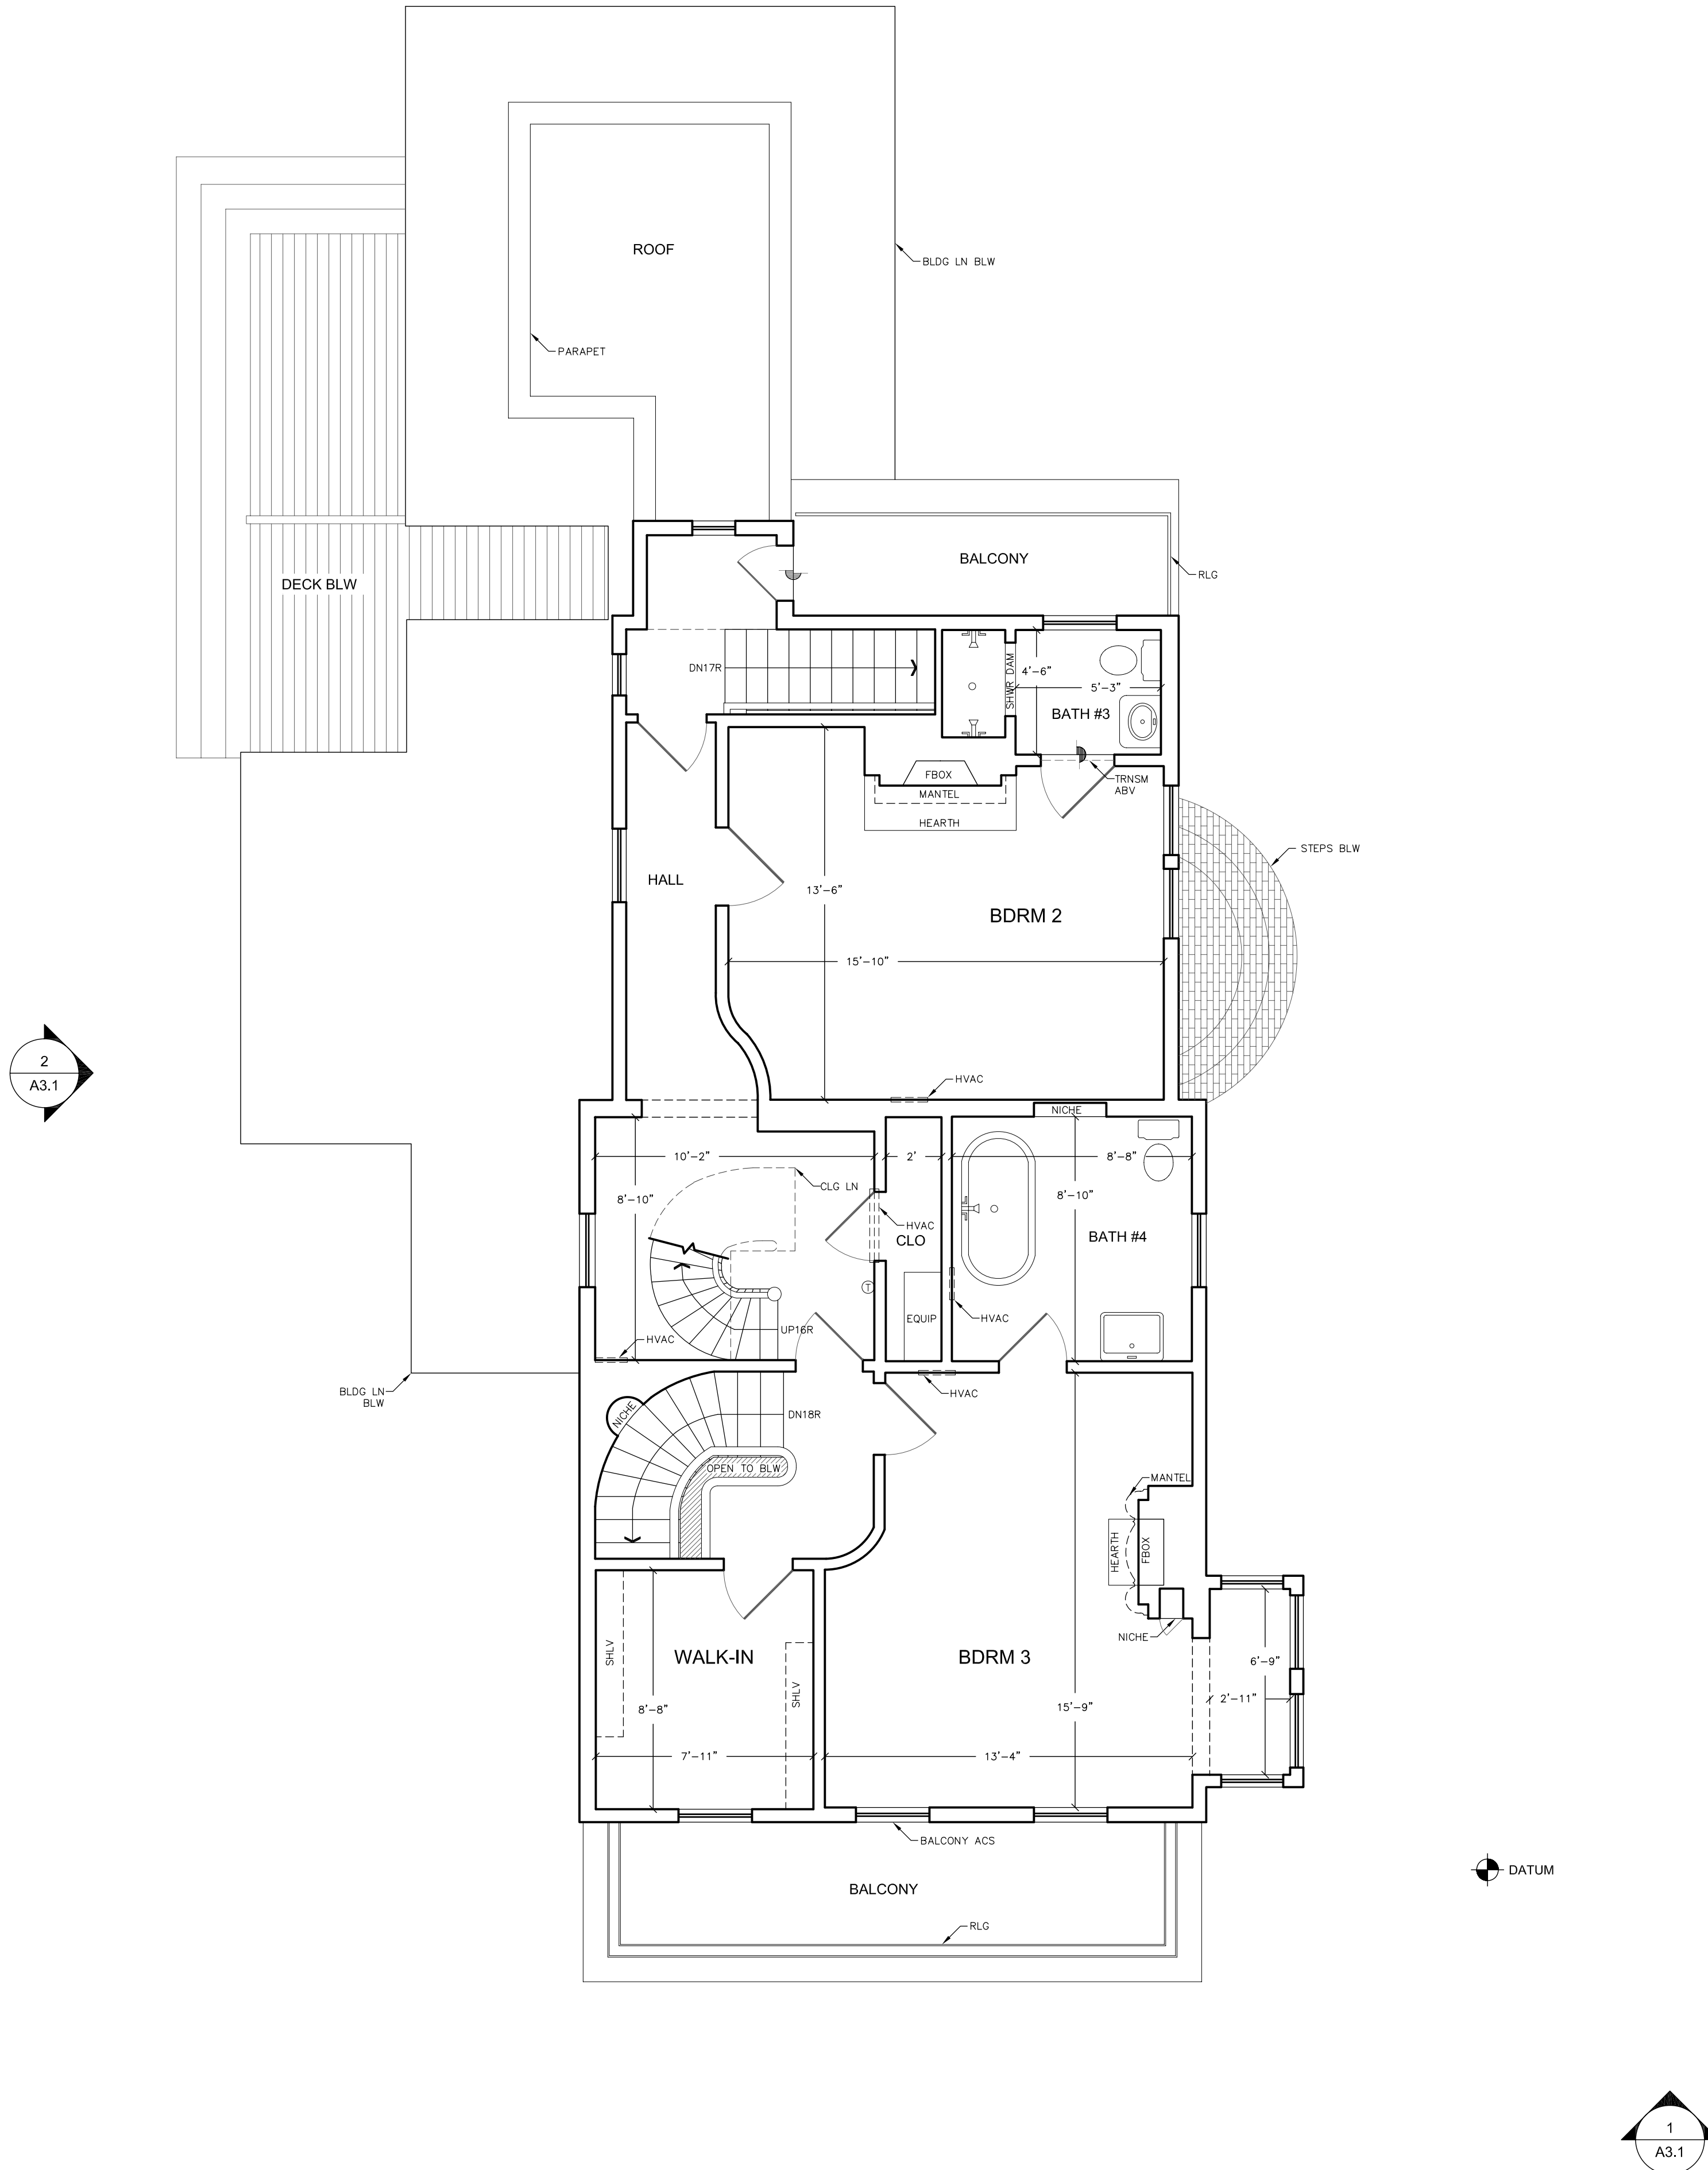

**2** EXISTING SECOND LEVEL FLOOR PLAN  
 1,004 SQFT INTERIOR  
 199 SQFT EXTERIOR  
 SCALE : 1/4"=1'-0"

1  
A3.2

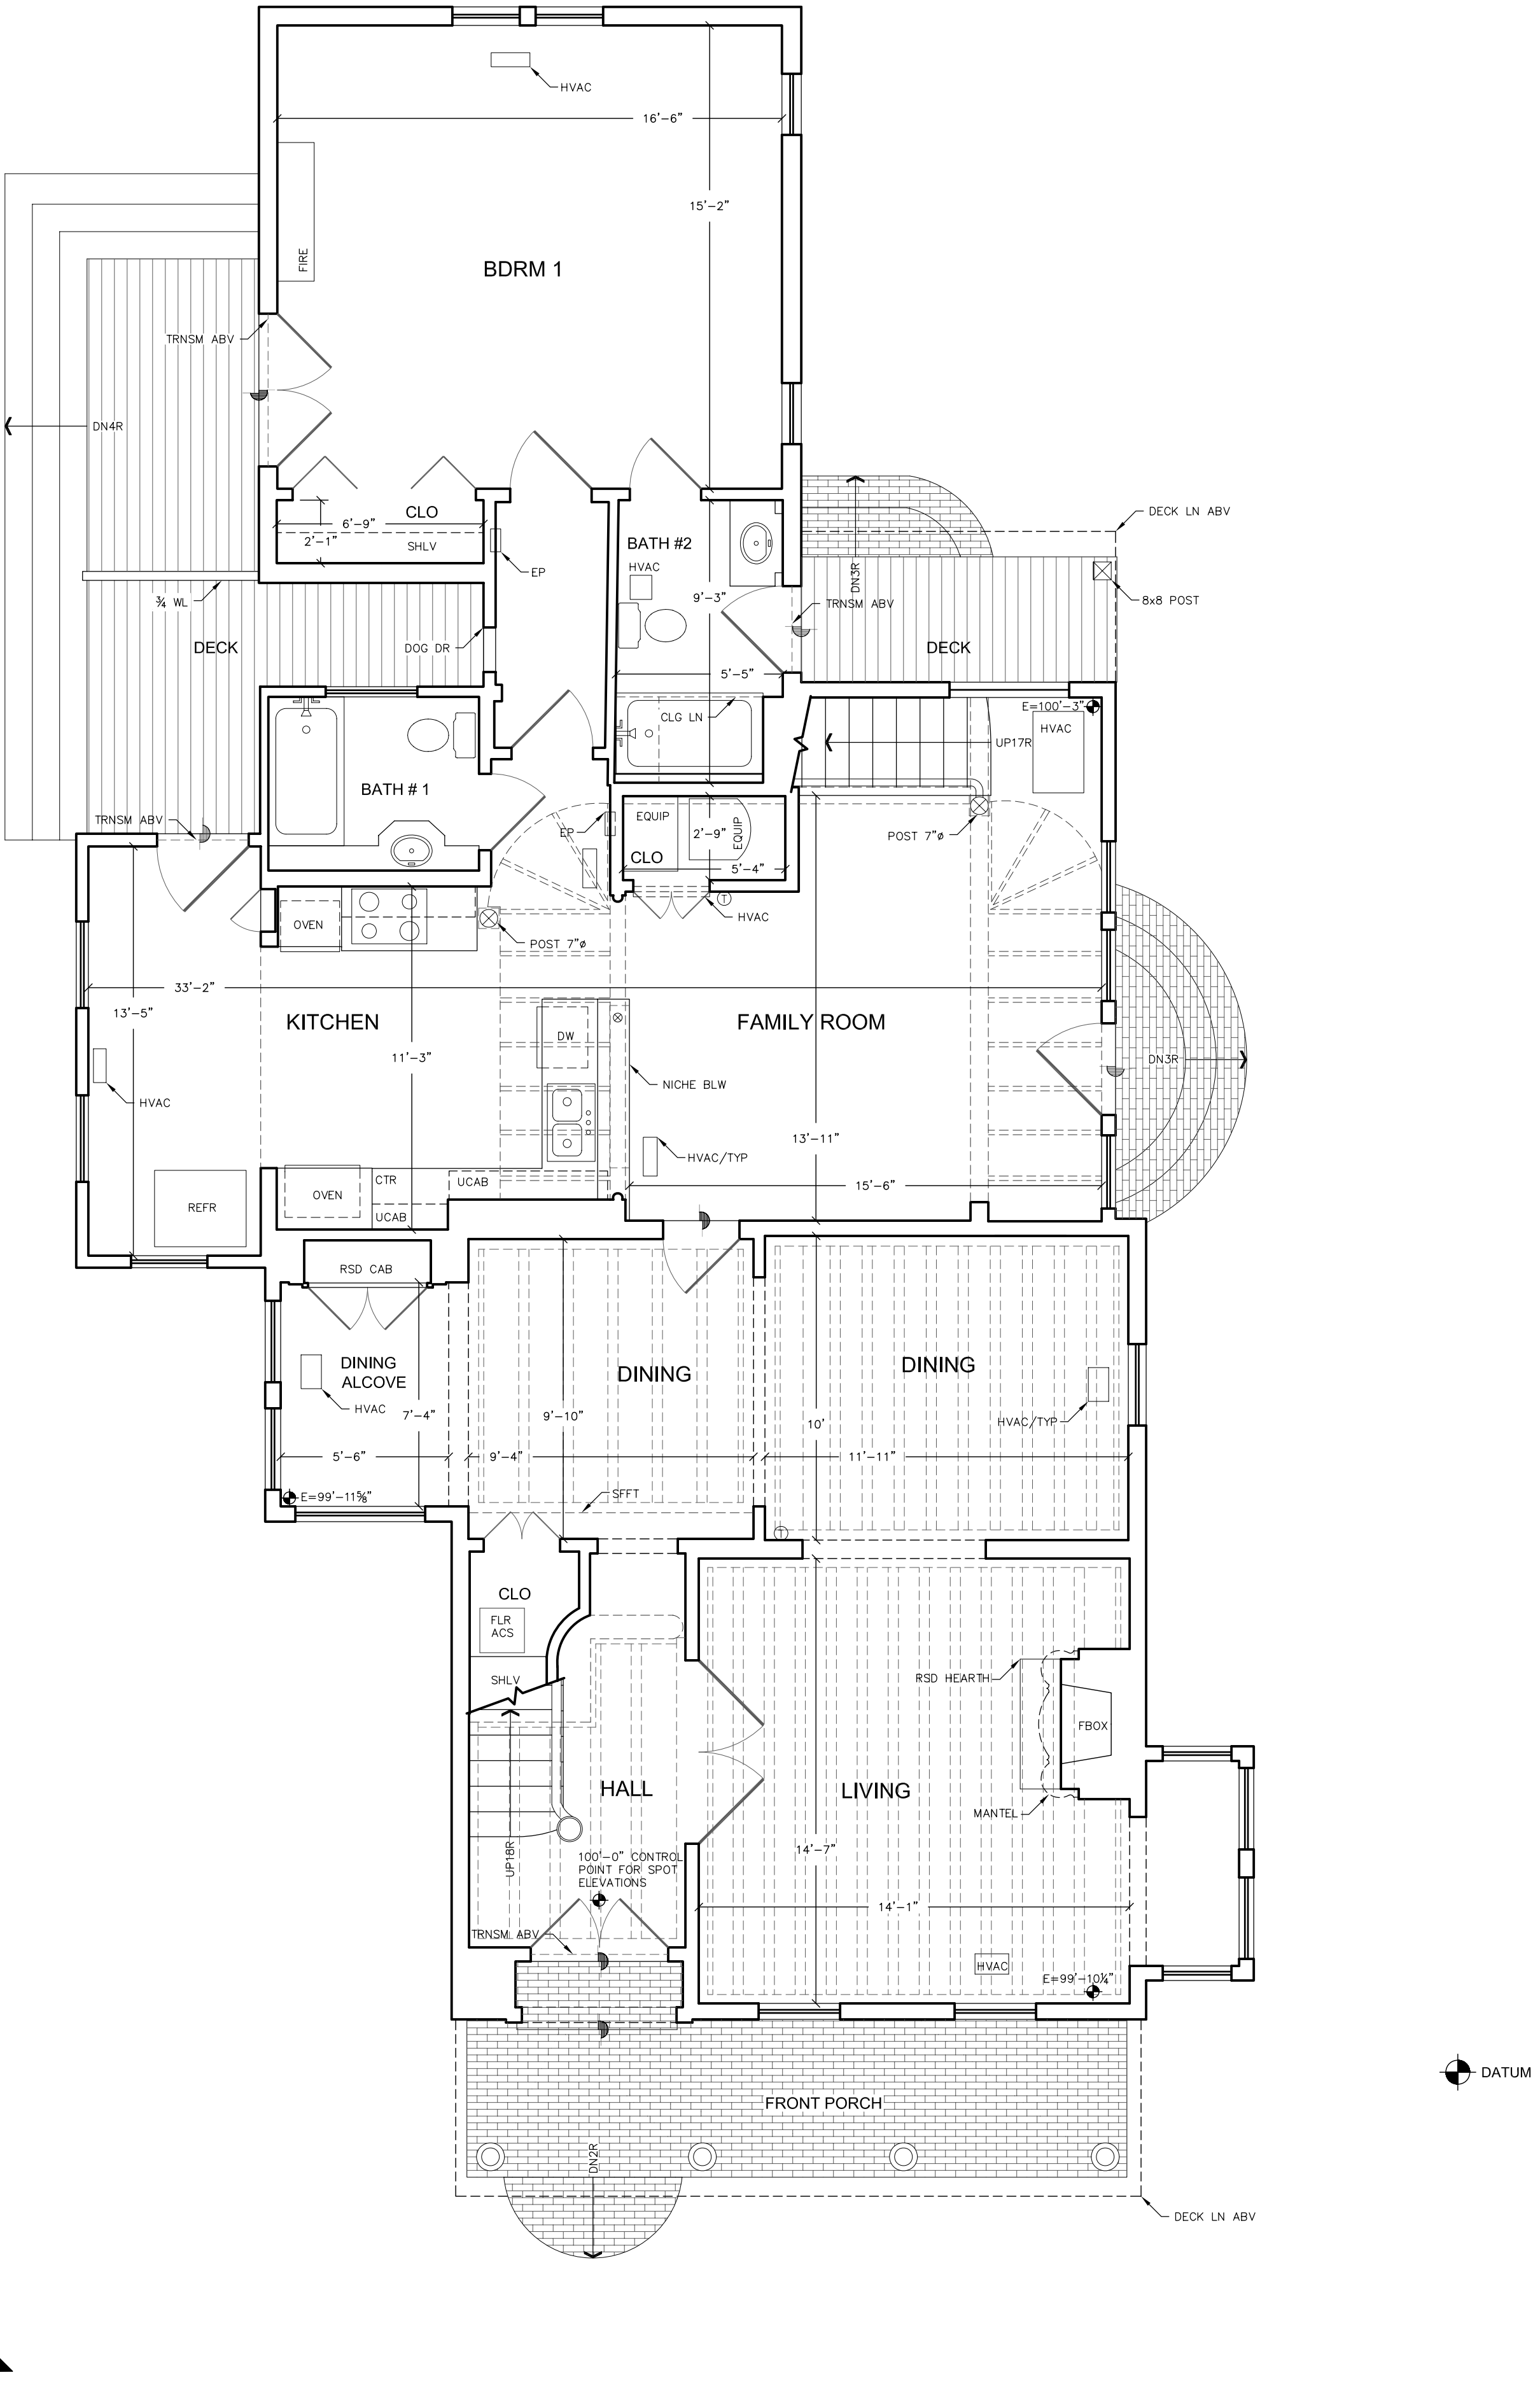


**1** EXISTING ENTRY LEVEL FLOOR PLAN  
 1,619 SQFT INTERIOR  
 432 SQFT EXTERIOR  
 SCALE : 1/4"=1'-0"

EXISTING FLOOR PLANS  
 CALISTOGA, CA. 94515

A2.1



2 EXISTING WEST ELEVATION  
 SCALE : 1/4"=1'-0"

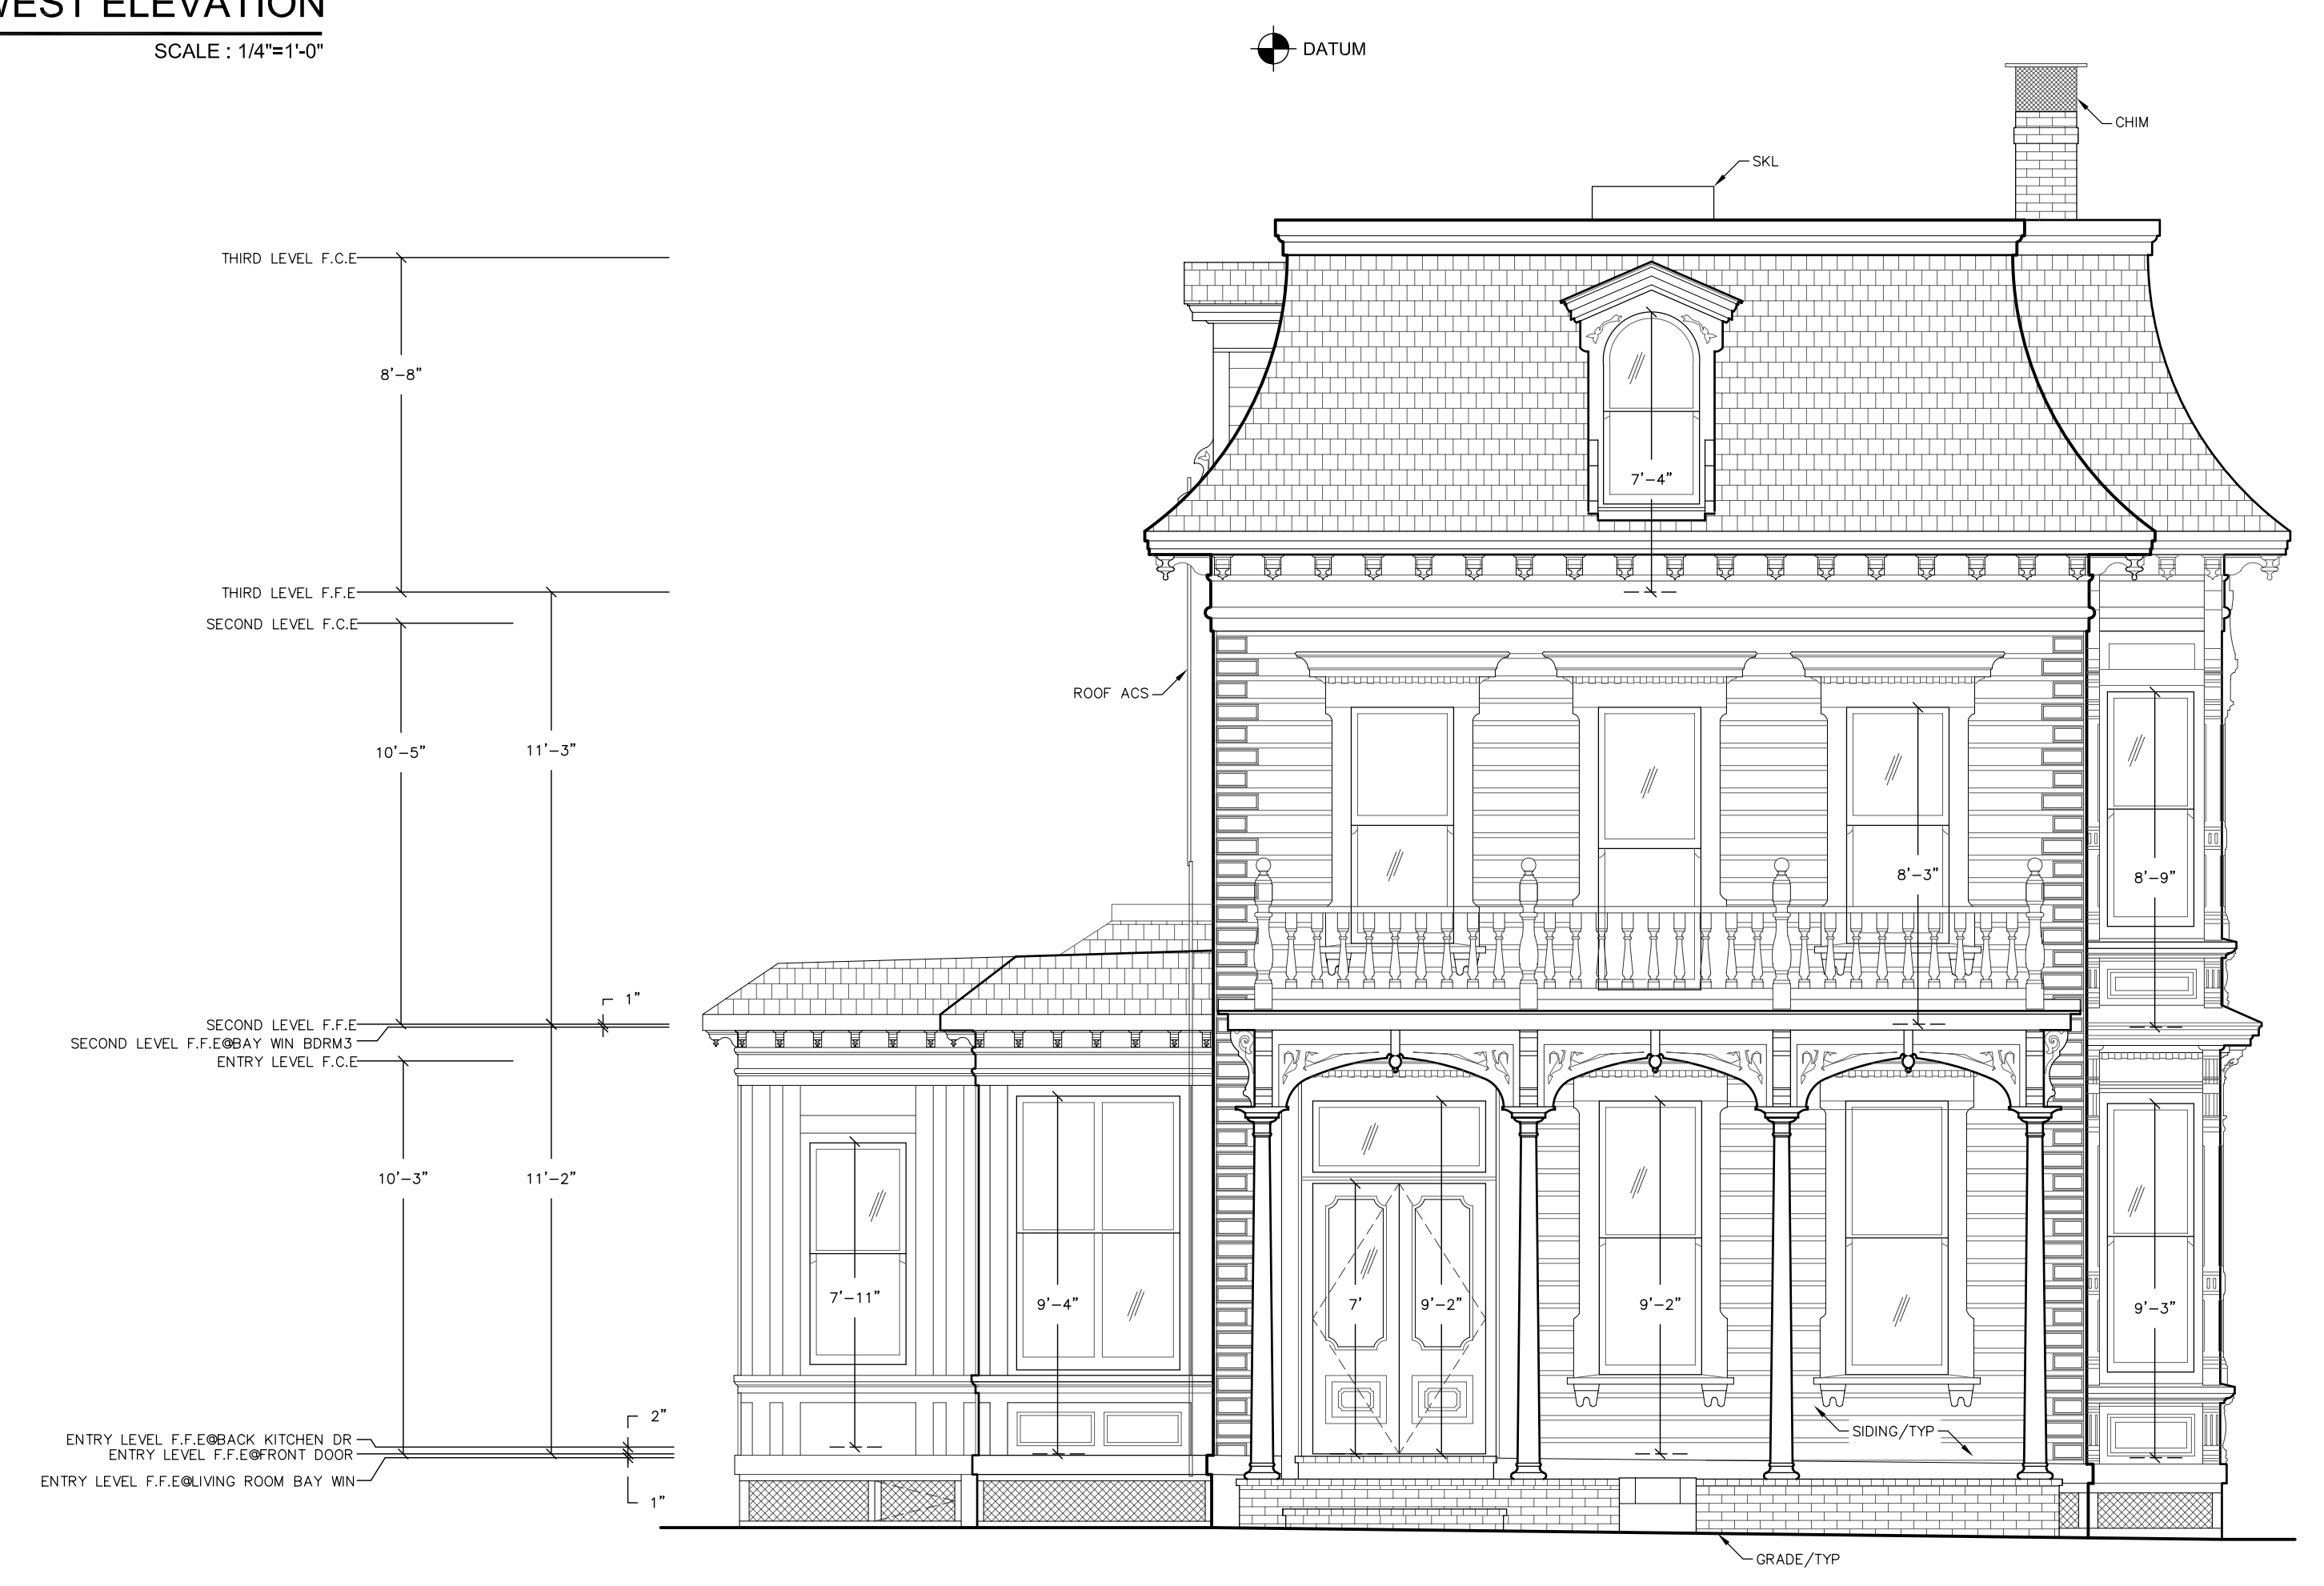

1 EXISTING NORTH ELEVATION  
 SCALE : 1/4"=1'-0"

EXISTING ELEVATIONS  
 CALISTOGA, CA. 94515